

State Well Report

Part 1 - Driller's Log

Mississippi Department of Environmental Quality
Office of Land and Water Resources
P.O. Box 2309
Jackson, MS 39225
(601)961- 5210
(601)961- 5228 (fax)

County: Sharkey
Permit #: GW-44719
Irrigation Equipment
Driller:
Date drilling completed: 11-1-10

For Office Use Only:
Aquifer: C 189
Well #:
L. S. Elevation:
E-log #:

State Law requires that this report be prepared by the license holder responsible for the work and filed with the Department at the above address within 30 days of completion of drilling of the well or borehole.

Information on Well Owner (Landowner if borehole is not for a water well)
Owner Name: Howle Planting
Mailing Address: 137 Jefferson St.
Anguilla Ms. 38721
City State Zip Code
Telephone No.
Well or Borehole Location
Latitude: 32.58 38.9 Longitude: 90.46.57.8
Method of Lat/Long (circle one): Conventional Survey,
USGS quad: Hand-held GPS Survey-grade GPS
NW 1/4 NE 1/4 Sec. 14 Twn 13N Rng 6W
Distance 3 Miles Direction E of Nearest Town Anguilla

Well / Borehole Data
Date drilling started: 11-1-10 Date drilling completed: 11-1-10 Hole depth: 106 Hole diameter: 18"
Location of the source of any surface water used for drilling: Surface Water
Method of dosing and volume of Chlorine used in drilling and development: 50 PPM
Logs run (circle all applicable): No log run Electric Gamma Ray Density Sonic Neutron Other:
Name of organization running log(s):
Purpose of borehole (check one): Water Well [checked] Geotechnical/Geological Investigation Ground Source Heat Pump
Seismic Survey Other (describe)
If drilling is not related to water well construction, skip the remainder of this block
Purpose of Well (check one): Home Industrial Public Supply Irrigation [checked] Fish Culture Other: Replacement
If a flowing well, method of flow regulation: Valve Other (describe)
Static Water Level: 22 feet above or below (circle one) land surface Date measured: 11-10-10
Method of Measurement (circle one): steel tape electric tape air line other:
Well depth: 106 Well grouted to a depth of 10 feet Type of grout (circle one): Neat Cement Bentonite Mix
Casing length: 66 total (see back) casing diameter: 10 inches Type of casing: PVC
Screen length: 40 feet Screen diameter: 10 inches Type of screen: PVC
Screen slot size: .050 inches Setting depth: From 62 61 feet to 101 feet
Type of completion (circle all applicable): Gravel packed Underreamed Telescoped Open hole Natural Development
Other (describe):
Top of lap pipe or reduction in casing: feet. If telescoped or more than one screen, describe on next page

Old Well 10" PVC 200' North

Form: OLWR-SWR-1A (04/08)

RECEIVED
NOV 29 2010
BY: OLWR

**STATE WELL REPORT
Part 2**

Pump Installer's Completion Report
Mississippi Department of Environmental Quality
Office of Land and Water Resources
P.O. Box 2309
Jackson, MS 39225
(601)961-5210
(601)961-5228 (fax)

County: Sharkey
 Permit #: GW-44719
 Irrigation Equipment
 Driller: _____
 Date completed: 11-1-10
Copy information from Meck on Part 1

For Office Use Only:

Aquifer: _____
 Well #: _____
 Elevation: _____

This part of the report must be completed by a licensed water well contractor or a licensed pump installer. A copy of Part 1 of the report must be attached and both parts filed with the Department at the above address within 30 days of well completion.

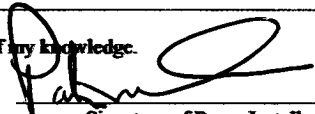
Well Owner Information	Well Location
Owner Name: <u>Howle Planting</u>	Latitude: _____ Longitude: _____
Mailing Address: <u>137 Jefferson St.</u>	Method of Lat/Long (check one): Conventional Survey _____
<u>Anguilla Ms. 38721</u>	USGS quad _____, Hand-held GPS <input checked="" type="checkbox"/> , Survey-grade GPS _____
City State Zip Code	<u>NW 1/4 NE 1/4 Sec 14 T 13N R 6W</u>
Telephone No. () _____	Distance Direction Nearest Town <u>2 Miles E of Anguilla</u>

Pump Type Circle one	Power Type Circle one
Air Lift Jet <input type="radio"/> <input checked="" type="radio"/> Submersible	Diesel Engine Gasoline Engine Natural Gas
Bucket Piston Turbine	<input checked="" type="radio"/> Electric Motor Hand Tractor PTO
Centrifugal Rotary Flowing Well	Windmill Other (specify): _____
Other (specify): _____	Horse Power Rating of Motor: <u>30</u>
Date Pump Installed: <u>11-10-10</u>	Setting Depth: <u>70</u> feet
Rated Pump Capacity: <u>1150 ±</u> Gallons Per Minute	Number of Stages: <u>1</u>

Pump Test Data	Method of Measuring Water Level Circle one
Date Well Tested: _____	Air Line Electric Measuring Line Steel Tape
Static Water Level (A): _____ Feet Below Land Surface	Other (specify): _____
Pumping Water Level (B): _____ Feet Below Land Surface	For flowing well, measured shut in head: _____ feet
Drawdown [(B) - (A)]: _____ Feet Below Land Surface	Well yielded _____ GPM with a drawdown of _____ feet after _____ hours of pumping
Test Pumping Rate: _____ Gallons Per Minute	
Duration of Pump Test (minimum 4 hours): _____ hours	

This is for (circle one): New Well Replacement of Existing Pump Repair of Existing Pump

I HEREBY CERTIFY that the above statements are true to the best of my knowledge.

Patrick M Chism 0695 

Print Name of Pump Installer and License No. (if applicable) Signature of Pump Installer

Form: OLWR-SWR-1C (07-09)

RECEIVED
 NOV 29 2010
 BY: OLWR