

Sharkey
Co.
7-6-76

MISSISSIPPI
 BOARD OF WATER COMMISSIONERS
 416 North State Street
 Jackson, Mississippi 39201

WATER WELL DRILLERS LOG

8-6-
 date well completed
7-6-76

154 Queensly & W. D. Dilling Sharkey
 firm name county well located

LANDOWNER: G.M. Baggett
Baggett Planting Co.
P.O. Box 385 Rolling Fork, MS. 39159
 (mailing address)

WELL LOCATION:
 sec. 26 T. 13 N R. 6 E
3 1/2 miles NE of Rolling Fork
 (distance) (direction) (nearest town)

WELL PURPOSE: HOME
 (home, irrigation, municipal, industrial)

WELL COMPLETION DATA:

- (1) diameter (inches) 4 x 2"
- (2) total depth (feet) 816 Ft.
- (3) static water level (feet) 19' below top of ground.
- (4) casing steel, 786'
 (material) (depth)
- NO if telescope see back.
 (size)
- (5) screen 30', 816'
 (length) (depth to top)
- 2", steel
 (size) (material)
- (6) pump 3, 45
 (HP) (yield gpm)
- (type power)
- (7) electric log NO
 (yes or no)
- (organization running log)
- (8) how well bottom plugged

description of formations encountered	from	to
top soil	0	18'
sand & gravel	18	336
clay	336	399
sand and gravel	399	441
clay	441	504
sand and gravel	504	1074
sand	1074	816


RECEIVED
 SEP 24 1976

MISS. BD. OF WATER COMMISSIONERS

DRILLERS REMARKS: Queens

If well telescopes please sketch and show depths.

GROUND LEVEL

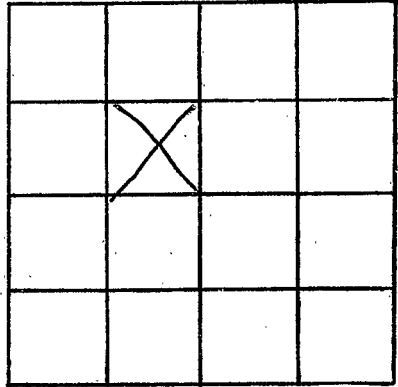

SECTION 6

Please indicate well location X.

ADDITIONAL INFORMATION

If more than one screen, show locations of each on sketch.