

SHARKEY  
 C 2003  
 6-6-77

MISSISSIPPI  
 BOARD OF WATER COMMISSIONERS  
 416 North State Street  
 Jackson, Mississippi 39201

WATER WELL DRILLERS LOG

June 6 1977 date well completed  
 Owens Pkg. Well Drilling Sharkey firm name  
 county well located

LANDOWNER: Rosenet Williams  
RT Box 17 Kellogg  
Tusk. (mailing address)

WELL LOCATION:  
 sec. B T. B N. R. 7 E. S. W  
3 1/4 miles west of Osquillo  
 (distance) (direction) (nearest town)

WELL PURPOSE: Home  
 (home, irrigation, municipal, industrial)

WELL COMPLETION DATA:  
 (1) diameter (inches) 2"  
 (2) total depth (feet) 630'  
 (3) static water level (feet) 20' below top of ground.  
 (4) casing PVC 610'  
 (material) (depth)  
 (size) If telescope see back.  
 (5) screen 20' 630'  
 (length) (depth to top)  
2" PVC  
 (size) (material)  
 (6) pump 1 14  
 (HP) (yield gpm)  
Elec  
 (type power)  
 (7) electric log no  
 (yes or no)  
 (organization running log)  
 (8) how well bottom plugged S/B

| description of formations encountered | from to |     |
|---------------------------------------|---------|-----|
|                                       |         |     |
| top soil                              | 0       | 36  |
| clay                                  | 26      | 139 |
| sand + gravel                         | 139     | 155 |
| sand + gravel                         | 155     | 179 |
| sand                                  | 179     | 309 |
| clay                                  | 309     | 370 |
| sand                                  | 370     | 630 |

RECEIVED


JUN 8 4 1977

MISS. BD. OF WATER COMMISSIONERS

DRILLERS REMARKS: Owens Pkg. Well Drilling

If well telescopes please sketch and show depths.

GROUND LEVEL

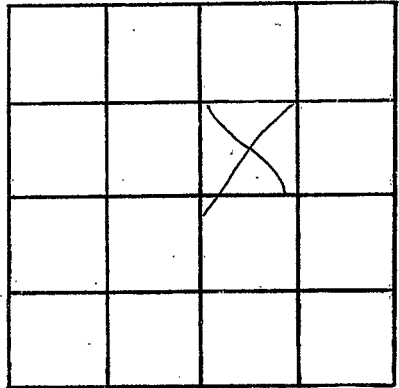

SECTION 7

Please indicate well location X.

ADDITIONAL INFORMATION

If more than one screen, show locations of each on sketch.