

MISSISSIPPI DEPARTMENT OF NATURAL RESOURCES

Bureau of Land and Water Resources

Southport Mall

P.O. Box 10631

Jackson, Mississippi 39209

WATER WELL DRILLERS LOG

Sharkey
C-2005

May 8 1984 E.M. "Bud" Cresswell Sharkey
date well completed firm name county well located

LANDOWNER:
W.C. FORTNER
Adquilla, MS.
(mailing address)

description of formations encountered	from	to
Clay	0	40
Sand-gravel	40	110

WELL LOCATION:
sec. 16 T 13 N R 6 W
At Adquilla
(distance) miles (direction) of (nearest town)

WELL PURPOSE: Industrial
(home, irrigation, municipal, industrial)

WELL COMPLETION DATA:
(1) diameter (inches) 4
(2) total depth (feet) 110
(3) static water level (feet) 8 below above top of ground.
(4) casing PVC 70
(material) (depth)
4 (size) if telescope see back.
(5) screen 40 70
(length) (depth to top)
4 PVC
(size) (material)
(6) pump 5 100
(HP) (yield gpm)
(type power) No
(7) electric log No
(yes or no)
(organization running log)

(8) how well bottom plugged
Pack Wash valve


DRILLERS REMARKS:

DEPT. OF NATURAL RESOURCES
BUREAU OF LAND & WATER RESOURCES

MAY 24 1984
RECEIVED

If well telescopes please sketch and show depths.

GROUND LEVEL

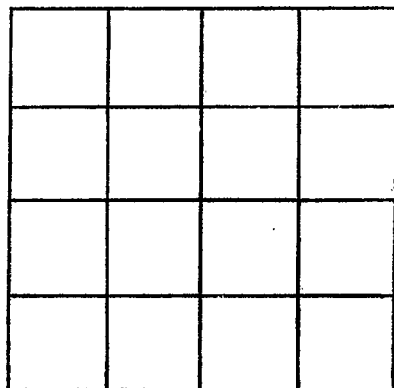

SECTION _____

Please indicate well location X.

ADDITIONAL INFORMATION

If more than one screen, show locations of each on sketch.