

MISSISSIPPI DEPARTMENT OF NATURAL RESOURCES

Bureau of Land and Water Resources

P.O. Box 10631

Jackson, Mississippi 39209

WATER WELL DRILLERS LOG

186

COUNTY WELL LOCATED
Sharky

WELL NUMBER CODED

2009

DATE WELL COMPLETED
4-11-91

PERMIT NUMBER

NAME OF DRILLING FIRM
Dyn Well

NAME & MAILING ADDRESS OF LANDOWNER
Sunflower Catfish Farm

Box 98

Anguilla Ms. 38721

WELL LOCATION: SEC TOWNSHIP RANGE
22 13 N 6 E

DISTANCE DIRECTION NEAREST TOWN
Miles of

OTHER LANDMARK

WELL PURPOSE: Home, Irrigation, Municipal, Industrial, Fish Pond, etc.

PUMP DATA

PUMP TYPE (Circle One):
Submersible, Turbine, Jet Flowing Well,
Other (Describe)

POWER TYPE (Circle One):
Electric, Tractor, Diesel, Gasoline, Butane,
Other (Describe) H/P

Pump Capacity (GPM) No. of Stages Setting Depth
3000 1 60 FT.

PUMP TEST

Well yielded _____ GPM with
a drawdown of _____ ft.
after _____ hours of pumping

WELL DATA

Well Depth <i>120'</i>	Casing Diameter (In.) <i>16"</i>	Casing Length (Ft.) <i>80'</i>
Type of Casing <i>steel</i>	Hole Depth	Depth to Static Water Level

TYPE OF COMPLETION: (Circle One or More):
Gravel Packed, Underreamed, Telescoped,
Natural Development, Open Hole, Other
(Describe)

Top of Lap Pipe or Reduction in Casing

FEET IF TELESCOPED OR MORE THAN ONE SCREEN: USE BACK PAGE

LOG DATA

TYPE OF LOG RUN (Circle One):
Electric, Gamma Ray, Density, Sonic, Neutron,
Other (Describe) No Log Run

Name of Organization Running Log
None

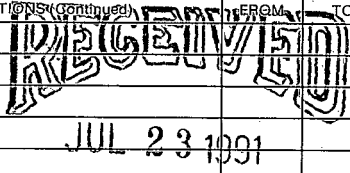
SCREEN DATA

Diameter - Inches <i>16"</i>	Length - Feet <i>40'</i>	Slot Size - Inches <i>.030</i>
Screen Type <i>Wire Wraps</i>	Depth to Bottom - Feet	

GEOLOGIC DATA (Office Use Only)

Surface Elev.	Geologic Unit	Unit Thickness	Depth to Top
Subs. SWL	Date	Analysis	Aquifer Test

Driller's Remarks

DESCRIPTION OF FORMATIONS ENCOUNTERED	FROM	TO	FORMATION (If Continued)	FROM	TO
<i>Clay</i>	<i>0</i>	<i>26</i>			
<i>Fine Sand</i>	<i>26</i>	<i>45</i>			
<i>Fine Sand + Gravel</i>	<i>45</i>	<i>93</i>			
<i>Fine Sand</i>	<i>93</i>	<i>102</i>			
<i>Fine Sand + Gravel</i>	<i>102</i>	<i>115</i>			
<i>M Sand + Gravel</i>	<i>115</i>	<i>120</i>			

JUL 23 1991

Dept. of Environmental Quality
Bureau of Land & Water Resources

IF MORE SPACE IS NEEDED, USE BACK

If well telescopes please sketch and show depths.

GROUND LEVEL

SECTION _____

Please indicate well location X.

ADDITIONAL INFORMATION

If more than one screen,
show location of each on sketch.