

MISSISSIPPI DEPARTMENT OF ENVIRONMENTAL QUALITY
Bureau of Land and Water Resources

P. O. Box 10631
Jackson, MS 39289-0631
WATER WELL DRILLERS LOG

COUNTY & WELL LOCATED
Sharkey

WELL NUMBER
C

DATE WELL COMPLETED
2013
3-9-93

PERMIT NUMBER

NAME OF DRILLING FIRM
Schudco Ltd

NAME & MAILING ADDRESS OF LANDOWNER
Sam Harris

WELL LOCATION: SEC *3* TOWNSHIP *13* RANGE *7*

DISTANCE *4* Miles DIRECTION *West* of NEAREST TOWN *Cameta*

OTHER LANDMARK

WELL PURPOSE: Home, Irrigation, Municipal, Industrial, Fish Pond, etc.
Fish Hatchery

PUMP DATA

PUMP TYPE (Circle One):
 Submersible Turbine, Jet, Flowing Well,
Other (Describe)

POWER TYPE (Circle One):
 Electric Tractor, Diesel, Gasoline, Butane,
Other (Describe) H/P *10*

Pump Capacity (GPM) *500* No. of Stages *2* Setting Depth *60* FT.

PUMP TEST

Well yielded _____ GPM with
a drawdown of _____ ft.
after _____ hours of pumping

WELL DATA

Well Depth <i>92</i>	Casing Diameter (In.) <i>10</i>	Casing Length (Ft.) <i>72</i>
Type of Casing <i>pvc</i>	Hole Depth <i>92</i>	Depth to Static Water Level <i>5ft 8in</i>

TYPE OF COMPLETION: (Circle One or More):
 Gravel Packed, Underreamed, Telescoped,
 Natural Development, Open Hole, Other
(Describe) *Hole plug*

Top of Lap Pipe or Reduction in Casing

FEET IF TELESCOPED OR MORE THAN ONE SCREEN: USE BACK PAGE

LOG DATA

TYPE OF LOG RUN (Circle One):
 No Log Run,
Electric, Gamma Ray, Density, Sonic, Neutron,
Other (Describe)

Name of Organization Running Log

SCREEN DATA

Diameter - Inches <i>10</i>	Length - Feet <i>20</i>	Slot Size - Inches <i>.030</i>
Screen Type <i>pvc</i>	Depth to Bottom - Feet <i>92</i>	

GEOLOGIC DATA (Office Use Only)

Surface Elev.	Geologic Unit	Unit Thickness	Depth to Top
Subs. SWL	Date	Analysis	Aquifer Test

Driller's Remarks

DESCRIPTION OF FORMATIONS ENCOUNTERED	FROM	TO	FORMATIONS (Continued)	FROM	TO
<i>clay</i>	<i>0</i>	<i>30</i>			
<i>Fine to med sand</i>	<i>30</i>	<i>50</i>			
<i>Course sand + p.g. gravel</i>	<i>50</i>	<i>91</i>			
<i>fine sand</i>	<i>91</i>	<i>92</i>			


APR 28 1993

Dept. of Environmental Quality
Office of Land & Water Resources

IF MORE SPACE IS NEEDED, USE BACK

If well telescopes please
sketch and show depths.

GROUND LEVEL

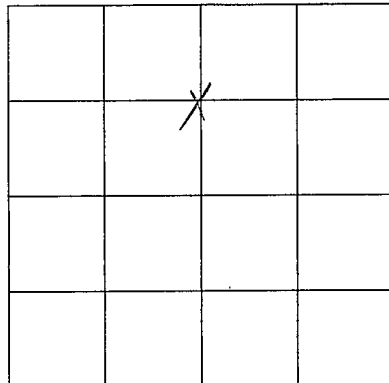

SECTION 3

Please indicate well location X.

ADDITIONAL INFORMATION

If more than one screen,
show location of each on sketch.