

**MISSISSIPPI DEPARTMENT OF ENVIRONMENTAL QUALITY**  
Office of Land and Water Resources

P. O. Box 10631  
Jackson, MS 39289-0631  
**WATER WELL DRILLERS LOG**

COUNTY WELL LOCATED <b>Sharkey</b>	
WELL NUMBER <b>C</b>	CODED
<b>2017</b>	
DATE WELL COMPLETED <b>3-31-95</b>	

PERMIT NUMBER <b>MSGW10107</b>
NAME OF DRILLING FIRM <b>Irrigation Equipment</b>
<b>Indianola, MS</b>

NAME & MAILING ADDRESS OF LANDOWNER <b>WELLSPRING</b>		
<b>P.O. BOX 194</b>		
<b>ROLLING FORK, MS 39159</b>		
WELL LOCATION: SEC	TOWNSHIP	RANGE
<b>33</b>	<b>13N S</b>	<b>6W E W</b>
DISTANCE	DIRECTION	NEAREST TOWN
<b>5</b> Miles	<b>NE</b>	<b>Rolling Fork</b>
OTHER LANDMARK		
WELL PURPOSE: Home, Irrigation, Municipal, Industrial, Fish Pond, etc. <b>Fish Pond</b>		

PUMP DATA		
PUMP TYPE (Circle One): Submersible, <b>Turbine</b> Jet Flowing Well, Other (Describe) _____		
POWER TYPE (Circle One): <b>Electric</b> Tractor, Diesel, Gasoline, Butane, Other (Describe) _____ H/P <b>60</b>		
Pump Capacity (GPM) <b>3000</b>	No. of Stages <b>1</b>	Setting Depth <b>70</b> FT.
PUMP TEST Well yielded _____ GPM with a drawdown of _____ ft. after _____ hours of pumping		

WELL DATA		
Well Depth <b>115</b>	Casing Diameter (In.) <b>16</b>	Casing Length (Ft.) <b>75</b>
Type of Casing <b>Steel</b>	Hole Depth <b>115</b>	Depth to Static Water Level <b>22 ft.</b>

LOG DATA	
TYPE OF LOG RUN (Circle One): No Log Run, Electric, Gamma Ray, Density, Sonic, Neutron, Other (Describe) _____	
Name of Organization Running Log	

TYPE OF COMPLETION: (Circle One or More): <b>Gravel Packed</b> Underreamed, Telescoped, Natural Development, Open Hole, Other (Describe) _____	
WELL GROUTED TO A DEPTH OF _____ FEET Type Grout (circle one): Cement, Bentonite, or Mix	

GEOLOGIC DATA (Office Use Only)			
Surface Elev.	Geologic Unit	Unit Thickness	Depth to Top
Subs. SWL	Date	Analysis	Aquifer Test

SCREEN DATA		
Diameter - Inches <b>16</b>	Length - Feet <b>40</b>	Slot Size - Inches <b>.060</b>
Screen Type <b>Steel</b>	Depth to Bottom - Feet <b>115</b>	


Driller's Remarks	
Top of Lap Pipe or Reduction in Casing	
FEET	IF TELESCOPED OR MORE THAN ONE SCREEN: USE BACK PAGE

DESCRIPTION OF FORMATIONS ENCOUNTERED	FROM	TO
Clay	0	25
Fine Sand	25	45
Fine Sand & Gravel	45	55
Med. Sand & Gravel	55	85
Fine Sand & Gravel	85	95
Med. Sand & Gravel	95	115

FORMATIONS (Continued)	FROM	TO
<b>RECEIVED</b>		
<b>MAY 09 1995</b>		
Dept. of Environmental Quality Office of Land & Water Resources		
IF MORE SPACE IS NEEDED, USE BACK		

If well telescopes please  
sketch and show depths.

GROUND LEVEL

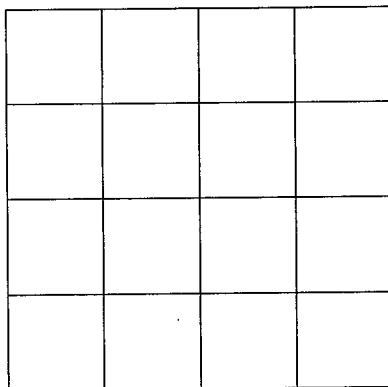

33

SECTION \_\_\_\_\_

Please indicate well location X.

ADDITIONAL INFORMATION

If more than one screen,  
show location of each on sketch.