

**MISSISSIPPI DEPARTMENT OF ENVIRONMENTAL QUALITY**

Office of Land and Water Resources

P. O. Box 10631  
Jackson, MS 39289-0631

**WATER WELL DRILLERS LOG**

COUNTY WELL LOCATED <b>Sharkey</b>	
WELL NUMBER <b>C-2023</b>	CODED
DATE WELL COMPLETED <b>Oct 17 2000</b>	

PERMIT NUMBER
NAME OF DRILLING FIRM <b>Schudco Ltd</b>

NAME & MAILING ADDRESS OF LANDOWNER <b>Alonzo DAVIS</b>			
<b>Anguilla, MS 38721</b>			
WELL LOCATION: SEC	TOWNSHIP	RANGE	
<b>18</b>	<b>13</b>	<b>(N) 6 (W)</b>	
DISTANCE	DIRECTION	NEAREST TOWN	
<b>1 1/2</b> Miles	<b>West</b>	<b>Anguilla</b>	
OTHER LANDMARK			
WELL PURPOSE: <input checked="" type="checkbox"/> Home Irrigation, <input type="checkbox"/> Municipal, <input type="checkbox"/> Industrial, <input type="checkbox"/> Fish Pond, etc.			

<b>PUMP DATA</b>		
PUMP TYPE (Circle One): <input checked="" type="checkbox"/> Submersible Turbine, Jet, Flowing Well, Other (Describe) _____		
POWER TYPE (Circle One): <input checked="" type="checkbox"/> Electric Tractor, Diesel, Gasoline, Butane, Other (Describe) _____ H/P <b>1</b>		
Pump Capacity (GPM) <b>20</b>	No. of Stages	Setting Depth <b>105</b> FT.
PUMP TEST		
Well yielded _____ GPM with a drawdown of _____ ft. after _____ hours of pumping		

<b>WELL DATA</b>		
Well Depth <b>420</b>	Casing Diameter (In.) <b>4x2</b>	Casing Length (Ft.) <b>400</b>
Type of Casing <b>pvc</b>	Hole Depth <b>440</b>	Depth to Static Water Level

TYPE OF COMPLETION: (Circle One or More):  
 Gravel Packed,  Underreamed,  Telescoped,  
 Natural Development,  Open Hole,  Other  
 (Describe) \_\_\_\_\_

WELL GROUTED TO A DEPTH OF **10** FEET  
 Type Grout (circle one): Cement, Bentonite, or Mix

<b>SCREEN DATA</b>		
Diameter - Inches <b>2</b>	Length - Feet <b>20</b>	Slot Size - Inches <b>1,008</b>
Screen Type <b>pvc</b>	Depth to Bottom - Feet <b>420</b>	

<b>LOG DATA</b>	
TYPE OF LOG RUN (Circle One): <input checked="" type="checkbox"/> No Log Run, Electric, Gamma Ray, Density, Sonic, Neutron, Other (Describe) _____	
Name of Organization Running Log	

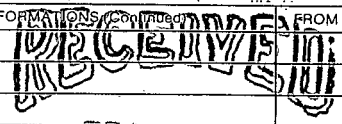
<b>GEOLOGIC DATA (Office Use Only)</b>			
Surface Elev.	Geologic Unit	Unit Thickness	Depth to Top
Subs. SWL	Date	Analysis	Aquifer Test

Driller's Remarks

---

Top of Lap Pipe or Reduction in Casing

FEET IF TELESCOPED OR MORE THAN ONE SCREEN: USE BACK PAGE

DESCRIPTION OF FORMATIONS ENCOUNTERED	FROM	TO	FORMATIONS CONTINUED	FROM	TO
clay	0	50	 <b>FEB 21 2001</b>  Dept. of Environmental Quality Office of Land & Water Resources		
sand	50	126			
Rock	126	127			
sand & clay	127	280			
clay	280	325			
Rock	325	326			
sand & clay streaks	326	360			
powder sand	360	380			
med sand	380	400			
course sand	400	430			
clay	430	440			

IF MORE SPACE IS NEEDED, USE BACK

