

MISSISSIPPI DEPARTMENT OF NATURAL RESOURCES

Bureau of Land and Water Resources

Southport Mall

P.O. Box 10631

Jackson, Mississippi 39209

WATER WELL DRILLERS LOG

Sharkey  
6-20-27

June 2 1982 L.M. "Bud" Cresswell Sharkey  
date well completed firm name county well located

LANDOWNER:	description of formations encountered	from	to
<u>Baggett Planting Co.</u> <u>Rollingfork, Ms.</u> (mailing address)			
<b>WELL LOCATION:</b>			
sec. <u>26</u> T. <u>13</u> N. R. <u>6</u> E. W. <u>4</u>			
<u>4</u> miles <u>EAST</u> of <u>Rollingfork</u>	(distance) (direction) (nearest town)		
<b>WELL PURPOSE:</b> <u>Home</u> (home, irrigation, municipal, industrial)			
<b>WELL COMPLETION DATA:</b>			
(1) diameter (inches) <u>4</u>			
(2) total depth (feet) <u>100</u>			
(3) static water level (feet) <u>20</u> below top of ground.			
(4) casing <u>PVC</u> <u>70</u> (material) (depth)			
<u>4</u> if telescope see back. (size)			
(5) screen <u>30</u> <u>70</u> (length) (depth to top)			
<u>4</u> <u>PVC</u> (size) (material)			
(6) pump <u>1</u> <u>25</u> (HP) (yield gpm)			
(type power)			
(7) electric log (yes or no)			
(organization running log)			
(8) how well bottom plugged <u>Hard Slack</u>			
<b>DRILLERS REMARKS:</b>			


DEPT. OF NATURAL RESOURCES  
BUREAU OF LAND & WATER RESOURCES

JUN -6 1982

RECEIVED

If well telescopes please  
sketch and show depths.

GROUND LEVEL

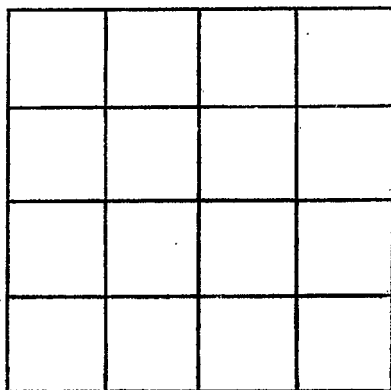

SECTION \_\_\_\_\_

Please indicate well location X.

ADDITIONAL INFORMATION

If more than one screen,  
show locations of each on sketch.