

SHARKEY
D 7
7-68

MISSISSIPPI
 BOARD OF WATER COMMISSIONERS
 416 North State Street
 Jackson, Mississippi 39201
 WATER WELL DRILLERS LOG

CODED

7-27 1968 Rolling Fork Machine Shop Sharkey
 date well completed firm name county well located

LANDOWNER:
A F Keith
Anguilla, Miss
 (mailing address)

description of formations encountered	from	to
<u>Loam</u>	<u>0</u>	<u>19</u>
<u>Blue clay</u>	<u>19</u>	<u>33</u>
<u>Sandy clay</u>	<u>33</u>	<u>42</u>
<u>Thin sand</u>	<u>42</u>	<u>74</u>
<u>sand + gravel</u>	<u>74</u>	<u>87</u>

WELL LOCATION:
 sec 3 T 13 N R 5
 S W
5 miles W of Louis
 (distance) (direction) (nearest town)

WELL PURPOSE: Cattle
 (home, irrigation, municipal, industrial)

WELL COMPLETION DATA:

(1) diameter (inches) 2"

(2) total depth (feet) 87

(3) static water level (feet) 12 below top of ground.

(4) casing 4" dia, 84'
 (material) (depth)

2" If telescope see back.
 (size)

(5) screen 3', 84'
 (length) (depth to top)

2", monel
 (size) (material)


(6) pump 1/2 9
 (HP) (yield gpm)

Electric
 (type power)

(7) electric log no
 (yes or no)

(organization running log)

CODED

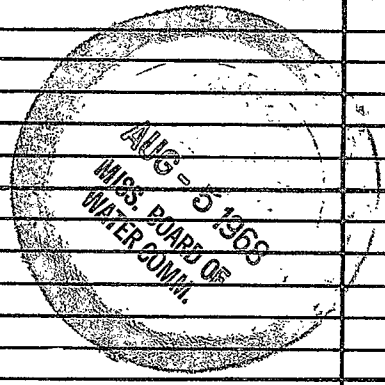


(8) how well bottom plugged
check valve

DRILLERS REMARKS:

If well telescopes please sketch and show depths.

GROUND LEVEL

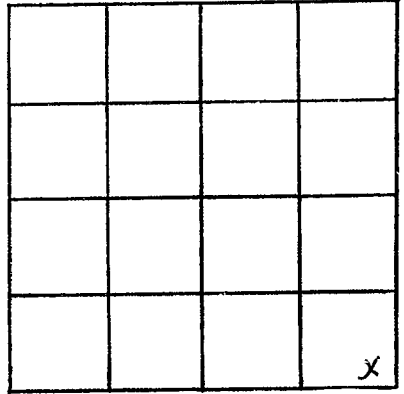

SECTION 2

Please indicate well location X.

ADDITIONAL INFORMATION

If more than one screen,
show locations of each on sketch.