

SHARKEY
D9
10/18/78

MISSISSIPPI
BOARD OF WATER COMMISSIONERS
416 North State Street
Jackson, Mississippi 39201

CODED

WATER WELL DRILLERS LOG

October 18, 1978 Dyer Well & Irr. Sharkey
date well completed firm name county well located

LANDOWNER: Raymond Brown

Anguilla, Miss.
(mailing address)

WELL LOCATION:
sec. 9 T-13 N R-5 E
4 miles West of Louise
(distance) (direction) (nearest town)

WELL PURPOSE: Irrigation
(home, irrigation, municipal, industrial)

WELL COMPLETION DATA:

- (1) diameter (inches): 12"
- (2) total depth (feet): 111'
- (3) static water level (feet) 126' below top of ground.
- (4) casing Steel, 71' (material) (depth)
12" (size) if telescope see back.
- (5) screen 40', 71' (length) (depth to top)
16" (size), Steel (material)
- (6) pump 600 (HP), 3000 (yield gpm)
Diesel (type power)
- (7) electric log No (yes or no)
(organization running log)
- (8) how well bottom plugged Plate

description of formations encountered	from	to
Clay	0	13
Clay	13	23
Clay	23	33
Clay + Fine Sand	33	43
Clay + Fine Sand	43	53
FINE SAND	53	63
SAND + GRAVEL	63	73
SAND + GRAVEL	73	83
SAND + GRAVEL	83	93
SAND + GRAVEL	93	103
SAND + GRAVEL	103	111


RECEIVED
NOV - 6 1978

MISS. BD. OF WATER COMM

DRILLERS REMARKS:

If well telescopes please sketch and show depths.

GROUND LEVEL

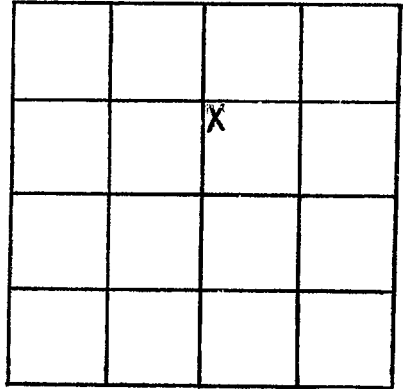

SECTION 9

Please indicate well location X.

ADDITIONAL INFORMATION

Lined area for additional information.

If more than one screen, show locations of each on sketch.