

SHARKEY
D10
10/19/78

MISSISSIPPI
BOARD OF WATER COMMISSIONERS
416 North State Street
Jackson, Mississippi 39201

CODED

WATER WELL DRILLERS LOG

October 19, 1978 Dyer Well & Irr. Sharkey
date well completed firm name county well located

LANDOWNER: <u>Raymond Brown</u>	description of formations encountered	from	to
<u>Anguilla, Miss.</u> (mailing address)	Clay	0	13
WELL LOCATION:	Clay	13	23
sec. <u>9</u> T. <u>13</u> N. R. <u>5</u> E	Clay	23	33
<u>4</u> miles <u>West</u> of <u>Louise</u> (distance) (direction) (nearest town)	Clay + Fine Sand	33	43
WELL PURPOSE: <u>Irrigation</u> (home, irrigation, municipal, industrial)	Fine Sand	43	53
WELL COMPLETION DATA:	Fine Sand	53	63
(1) diameter (inches) <u>16"</u>	SAND + GRAVEL	63	73
(2) total depth (feet) <u>108</u>	SAND + GRAVEL	73	83
(3) static water level (feet) <u>16"</u> below top of ground.	SAND + GRAVEL	83	93
(4) casing <u>STEEL</u> , <u>78'</u> (material) (depth)	SAND + GRAVEL	93	103
<u>16"</u> If telescope see back. (size)	GRAVEL	103	108
(5) screen <u>40'</u> , <u>68'</u> (length) (depth to top)			
<u>16"</u> , <u>STEEL</u> (size) (material)			
(6) pump <u>60</u> <u>3,000</u> (HP) (yield gpm)			
<u>DIESEL</u> (type power)			
(7) electric log <u>No</u> (yes or no)			
(organization running log)			
(8) how well bottom plugged <u>Plate</u>			
DRILLERS REMARKS:			


CODED

RECEIVED
NOV - 6 1978

MISS. BD. OF WATER COMMISSIONERS

If well telescopes please sketch and show depths.

GROUND LEVEL

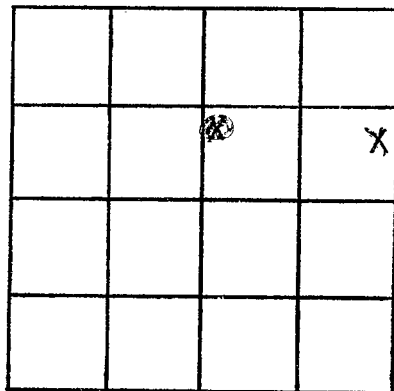

SECTION 9

Please indicate well location X.

ADDITIONAL INFORMATION

Lined area for additional information.

If more than one screen, show locations of each on sketch.