

SHARKEY
D-12
11/02/79

MISSISSIPPI
 BOARD OF WATER COMMISSIONERS
 416 North State Street
 Jackson, Mississippi 39201

CODED

WATER WELL DRILLERS LOG

Well # I

Nov 2, 1979 19 date well completed
 Dreiling & Associates firm name
 Sharkey county well located

LANDOWNER:	description of formations encountered	from	to
W. B. Holoway	Top Soil	0	5
Rolling Fork, Ms. 39159 (mailing address)	Top Soil (Cemented Sand & Clay)	5	10
	Cemented Sand & Clay	10	15
	Clay	15	20
WELL LOCATION:	Brown Clay	20	25
sec. <u>24</u> T. <u>13</u> N. R. <u>5</u> E. <u>W</u>	Fine Sand & Clay Strikes	25	30
6 miles W of Louise (distance) (direction) (nearest town)	Fine Sand	30	35
WELL PURPOSE: Irrigation (home, irrigation, municipal, industrial)	Fine Sand	35	40
WELL COMPLETION DATA:	Fine Sand & Clay St.	40	45
(1) diameter (inches) <u>22"</u>	Fine Sand & Clay St.	45	50
(2) total depth (feet) <u>120'</u>	Sand & Clay St.	50	55
(3) static water level (feet) <u>8</u> ^{below} top of ground.	Clay & Sand St.	55	60
(4) casing <u>Steel</u> <u>120'</u> (material) (depth)	Sand & Clay St.	60	65
<u> </u> if telescope see back. (size)	Sand & Clay St.	65	70
(5) screen <u>40'</u> <u>90</u> (length) (depth to top)	Sand & Clay St.	70	75
<u> </u> (size) <u> </u> (material)	Sand & Gravel	75	80
(6) pump <u>60</u> <u>3800</u> (HP) (yield gpm)	Big Gravel & Fine Sand	80	85
<u>Diesel</u> (type power)	Big Gravel & Sand	85	90
(7) electric log <u>No</u> (yes or no)	Big Gravel	90	95
<u> </u> (organization running log)	Gravel & Rock	95	100
(8) how well bottom plugged <u>CLAY</u>	Gravel & Sand	100	105
	Gravel & Sand	105	110
	Gravel & Sand Clay	115	120
	Bottom 120'		
DRILLERS REMARKS:			


DEPT. OF NATURAL RESOURCES
 BUREAU OF LAND & WATER RESOURCES

MAY 19 1980

RECEIVED

If well telescopes please sketch and show depths.

GROUND LEVEL

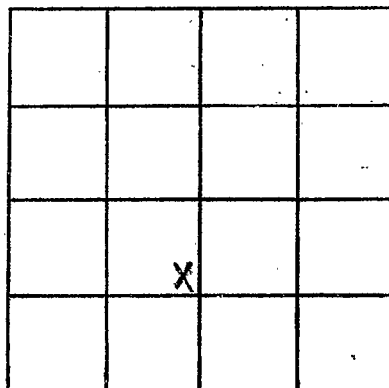

SECTION _____

Please indicate well location X.

ADDITIONAL INFORMATION

If more than one screen, show locations of each on sketch.