

SHARKEY  
D 16

MISSISSIPPI  
BOARD OF WATER COMMISSIONERS  
416 North State Street  
Jackson, Mississippi 39201

CODED

#2

WATER WELL DRILLERS LOG

12/22/80  
12-22-80  
date well completed

Rolling & associates  
firm name

Sharkey  
county well located

LANDOWNER:

JOE CARSON  
Rolling Fork, MS  
(mailing address) 39159

WELL LOCATION:

sec. 20 T. 13 N R 5 E  
S W  
6 miles E of Anquilla  
(distance) (direction) (nearest town)

WELL PURPOSE: irrigation  
(home, irrigation, municipal, industrial)

WELL COMPLETION DATA:

- (1) diameter (inches) 26"
- (2) total depth (feet) 100'
- (3) static water level (feet) 18' below top of ground.
- (4) casing steel 80' (material), (depth), 16' (size) if telescope see back.
- (5) screen 20' 8' (length), (depth to top) 16' steel (size), (material)
- (6) pump 75 1200 (HP), (yield gpm) deisel (type power)
- (7) electric log no (yes or no)  
(organization running log)
- (8) how well bottom plugged steel plug

description of formations encountered

	from	to
Top Soil	0	5
Brown Clay	5	10
Fine Sand & Clay	10	15
Fine Sand & Clay	15	20
Fine Sand & Clay	20	25
Fine Sand & Clay	25	30
Course Sand & Gravel	30	35
Sm. Gravel & Med Sand	35	40
Lignight coal & Sand	40	45
Fine Sand	45	50
Fine Sand	50	55
Fine Sand	55	60
Fine Sand	60	65
Fine Sand & Large Gravel	65	70
Sand & Gravel	70	75
Sand & Gravel	75	80
Sand & Large Gravel	80	85
Sand & Large Gravel	85	90
Sand & Large Gravel	90	95
Sand & Large Gravel	95	100

DEPT. OF NATURAL RESOURCES  
BUREAU OF LAND & WATER RESOURCES

FEB 20 1981


RECEIVED

DRILLERS REMARKS:

03000

If well telescopes please sketch and show depths.

GROUND LEVEL

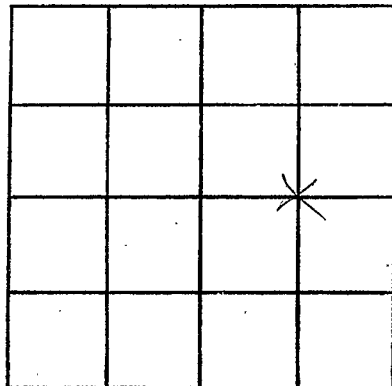

SECTION \_\_\_\_\_

Please indicate well location X.

ADDITIONAL INFORMATION

If more than one screen, show locations of each on sketch.