

SHARKEY
DIT

12/22/80
12-22

MISSISSIPPI
BOARD OF WATER COMMISSIONERS
416 North State Street
Jackson, Mississippi 39201

CODED

#1

WATER WELL DRILLERS LOG

19 80 Dreiling & Associates Sharkey
date well completed firm name county well located

LANDOWNER: Jae Carson
Rolling Fork, MS 39159

(mailing address)

WELL LOCATION:
sec. 20 T 13 (N) R 5 (E)
6 miles (distance) E (direction) of Anquilla (nearest town)

WELL PURPOSE: irrigation
(home, irrigation, municipal, industrial)

- WELL COMPLETION DATA:**
- (1) diameter (inches) 26"
 - (2) total depth (feet) 100'
 - (3) static water level (feet) 18' (below/above top of ground)
 - (4) casing steel 80' (material) (depth)
16" (size) if telescope see back.
 - (5) screen 20' 8' (length) (depth to top)
16" (size) steel (material)
 - (6) pump 75 1200 (HP) (yield gpm)
deisel (type power)
 - (7) electric log no (yes or no)
(organization running log)
 - (8) how well bottom plugged steel plug

description of formations encountered	from	to
Top Soil	0	5
Grey Clay	05	10
Fine Sand	10	15
Med. Sand/	15	20
Course sand/ Gravel	20	25
Med, sand gravel	25	30
Course Sand/ Gravel/Lignite	30	35
Med. Sand & Gravel	35	40
Grey Clay/Med.Sand	40	45
Grey Clay / Course Sand	45	50
Fine Sand & Gravel	50	55
Med. & Course Sand/Gravel	55	60
Course Sand & Gravel	60	65
Course Sand & Gravel	65	70
Course Sand & Gravel	70	75
Course Sand & Gravel	75	80
Course Sand & Gravel	80	85
Course Sand & Gravel	85	90
Course Sand & GravelMED	90	95
Med. Sand & Gravel	95	100

DEPT. OF NATURAL RESOURCES
BUREAU OF LAND & WATER RESOURCES


FEB 20 1981

RECEIVED

DRILLERS REMARKS:

If well telescopes please sketch and show depths.

GROUND LEVEL

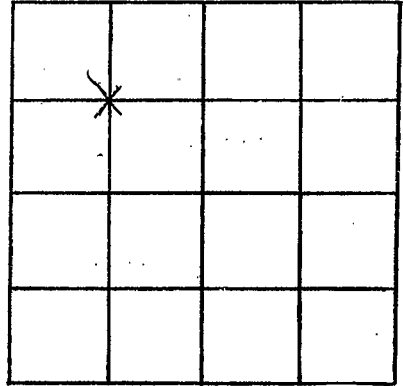

SECTION _____

Please indicate well location X.

ADDITIONAL INFORMATION

If more than one screen,
show locations of each on sketch.