

MISSISSIPPI DEPARTMENT OF NATURAL RESOURCES

Bureau of Land and Water Resources

Southport Mall

P.O. Box 10631

Jackson, Mississippi 39209

WATER WELL DRILLERS LOG

CODED

Shorkey
D 19
4-9-81

date well completed April 09 1981 Leamy's well & pump firm name Shorkey county well located

LANDOWNER: Raymond Brown

description of formations encountered	from	to
---------------------------------------	------	----

Anguilla, Miss
(mailing address)

CLAY	0	40
FINE SAND	40	75
MED SAND	75	90
CORSE SAND	90	136

WELL LOCATION:


sec. 3 T. 13 N R. 5 W
8 miles NE of Anguilla
(distance) (direction) (nearest town)

WELL PURPOSE: Fish Pond
(home, irrigation, municipal, industrial)

CODED

WELL COMPLETION DATA:

- (1) diameter (inches) 16"
- (2) total depth (feet) 136'
- (3) static water level (feet) 21 below above top of ground.
- (4) casing Steel, 96'
(material) (depth)
(size) If telescope see back.
- (5) screen 40', 96'
(length) (depth to top)
16", Steel
(size) (material)
- (6) pump 60, 3000
(HP) (yield gpm)
Electric
(type power)
- (7) electric log No
(yes or no)

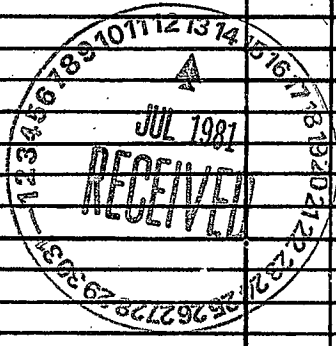


(organization running log)

(8) how well bottom plugged Steel Plate

DRILLERS REMARKS:

If well telescopes please
sketch and show depths.

GROUND LEVEL

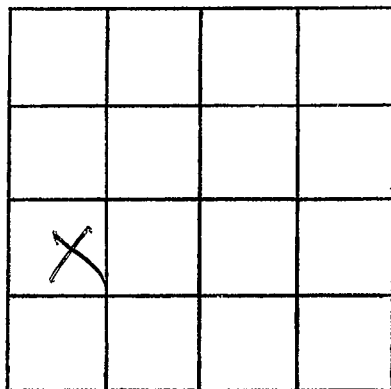

SECTION 3

Please indicate well location X.

ADDITIONAL INFORMATION

If more than one screen,
show locations of each on sketch.