

MISSISSIPPI DEPARTMENT OF NATURAL RESOURCES

Bureau of Land and Water Resources

Southport Mall

P.O. Box 10631

Jackson, Mississippi 39209

WATER WELL DRILLERS LOG

CODED

Shark Key
D 20
9/23/81

Sept. 23, 1981 date well completed Leroy's Well & Pump firm name Shark Key county well located

LANDOWNER: Raymond Brown
Angilla, Mo. (mailing address)

description of formations encountered	from	to
<u>Clay</u>	<u>0</u>	<u>30</u>
<u>Fine Sand</u>	<u>30</u>	<u>60</u>
<u>Coarse Sand</u>	<u>60</u>	<u>114</u>

WELL LOCATION:
 sec. 4 T. 13 N R. 5 W
7 miles E of Angilla
 (distance) (direction) (nearest town)

WELL PURPOSE: Fish Pond
 (home, irrigation, municipal, industrial)

WELL COMPLETION DATA:

(1) diameter (inches) 16"
 (2) total depth (feet) 114'
 (3) static water level (feet) 20' below above top of ground
 (4) casing Steel 16"
 (material) (depth)
 (size) if telescope see back.
 (5) screen 40" 76"
 (length) (depth to top)
16" Steel
 (size) (material)
 (6) pump 60 3000
 (HP) (yield gpm)
Electric
 (type power)
 (7) electric log No
 (yes or no)
 (organization running log)

(8) how well bottom plugged Steel
Pipe

DRILLERS REMARKS:

CODED


DEPT. OF NATURAL RESOURCES
 BUREAU OF LAND & WATER RESOURCES

JAN 8 - 1982

RECEIVED

If well telescopes please
sketch and show depths.

GROUND LEVEL

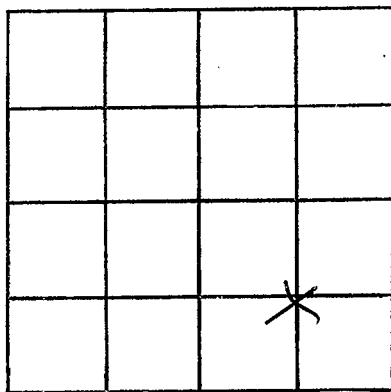

SECTION 4

Please indicate well location X.

ADDITIONAL INFORMATION

If more than one screen,
show locations of each on sketch.