

MISSISSIPPI DEPARTMENT OF NATURAL RESOURCES

Bureau of Land and Water Resources

Southport Mall

P.O. Box 10631

Jackson, Mississippi 39209

WATER WELL DRILLERS LOG


Sharkey  
D 24  
5/12/83

May 12 1983 E.M. "Bud" Cresswell Sharkey  
date well completed firm name county well located

LANDOWNER:	description of formations encountered	from	to
D.T. White			
Louise, Ms. (mailing address)	Clay	0	15
	Sand - gravel	15	145
	Clay	145	220
	Sand	220	380
	Shale - streaks sand	380	560
	Sand - rock	560	620
	Sand	620	780
WELL LOCATION:			
sec. 10 T 13 N R 5 E 5 miles West of Louise (distance) (direction) (nearest town)			
WELL PURPOSE: Home (home, irrigation, municipal, industrial)			
WELL COMPLETION DATA:			
(1) diameter (inches) 4	CODED		
(2) total depth (feet) 780			
(3) static water level (feet) 10 below top of ground.			
(4) casing Steel, 740 (material) (depth)			
4 (size) If telescope see back.			
(5) screen 40 740 (length) (depth to top)			
2 Stainless (size) (material)			
(6) pump 1 20 (HP) (yield gpm)			
(type power)			
(7) electric log NO (yes or no)			
(organization running log)			
(8) how well bottom plugged wash wash valve			
DRILLERS REMARKS:			

If well telescopes please sketch and show depths.

GROUND LEVEL

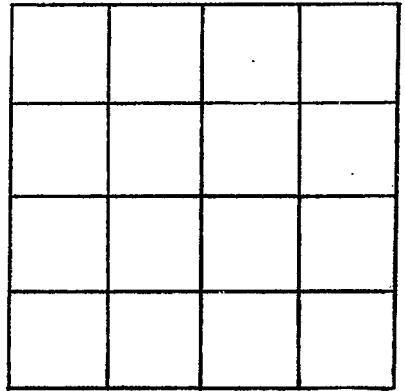

SECTION \_\_\_\_\_

Please indicate well location X.

ADDITIONAL INFORMATION

If more than one screen,  
show locations of each on sketch.