

MISSISSIPPI DEPARTMENT OF NATURAL RESOURCES
Bureau of Land and Water Resources
 Southport Mall
 P.O. Box 10631
 Jackson, Mississippi 39209
WATER WELL DRILLERS LOG

CODED

D26
 CL-2594 SHARKEY
 2-27-84

2/27 19 84 LAYNE CENTRAL CO. SHARKEY
 date well completed firm name county well located

LANDOWNER:	description of formations encountered	from	to
Truelight Redevelopment Group			
Anguilla, MS	sand	28	40
(mailing address)	coarse sand	40	90
WELL LOCATION:	coarse sand/pea gravel	90	141
sec. 3 T. 13 N R. 5 E W	clay	141	204
8 miles E of Anguilla	stks. of fine sand/shale	204	257
(distance) (direction) (nearest town)	clay	257	297
WELL PURPOSE: municipal	sand w/stks. of shale	297	375
(home, irrigation, municipal, industrial)	sandy shale	375	408
WELL COMPLETION DATA:	stks. of clay w/sand	408	437
(1) diameter (inches) 15"	sand w/stks. of clay	437	558
(2) total depth (feet) 1046'	hard clay	558	679
(3) static water level (feet) 20' 8" below top of ground.	sandy shale	679	709
(4) casing steel 991' (material) (depth)	stks. of sand w/shale	709	792
10" (size) if telescope see back.	rock	792	793
(5) screen 51' 995' (length) (depth to top)	stks. of sand w/shale	793	800
6" (size) st. steel (material)	hard cement sand	800	831
(6) pump 30 350 (HP) (yield gpm)	sandy shale	831	841
electric (type power)	rock	841	842
(7) electric log yes (yes or no)	sandy shale	842	890
Layne (organization running log)	stks. of sand /shale	890	941
6" BP valve	hard cement sand	941	953
(8) how well bottom plugged	shale w/stks. of sand	953	971
	shale	971	976
	stks. of sand w/shale	976	981
	sand (cut good)	981	1042
	shale	1042	1050

DEPT. OF NATURAL RESOURCES
 BUREAU OF LAND & WATER RESOURCES


MAY 17 1984

RECEIVED

DRILLERS REMARKS:

If well telescopes please sketch and show depths.

GROUND LEVEL

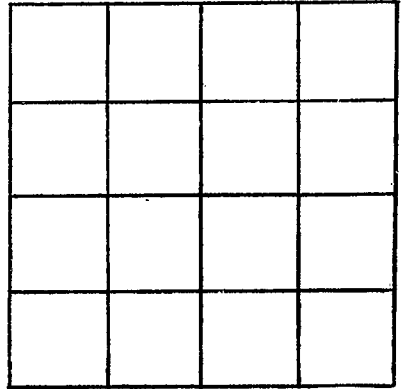

SECTION _____

Please indicate well location X.

ADDITIONAL INFORMATION

If more than one screen,
show locations of each on sketch.