

MISSISSIPPI DEPARTMENT OF NATURAL RESOURCES

Bureau of Land and Water Resources

Southport Mall

P.O. Box 10631

Jackson, Mississippi 39209

WATER WELL DRILLERS LOG

CODED

Sharkey  
D 27

June 12 1985

date well completed

Larry's well pump

firm name

Sharkey

county well located

LANDOWNER: Hodnett, Inc.

description of formations encountered

from

to

Arguilla, ms  
(mailing address)

CLAY 0 30  
FINE SAND 30 60  
COARSE SAND & GRAVEL 60 116

WELL LOCATION:

sec. 12 T. 13 N R. 5 E  
S W  
4 miles WEST of Louis  
(distance) (direction) (nearest town)

CODED

WELL PURPOSE: Fish pond  
(home, irrigation, municipal, industrial)

WELL COMPLETION DATA:

- (1) diameter (inches) 16"
- (2) total depth (feet) 116'
- (3) static water level (feet) 20' below top of ground.
- (4) casing Steel, 76',  
(material) (depth)  
         if telescope see back.  
(size)
- (5) screen 40', 76'  
(length) (depth to top)  
16", steel  
(size) (material)
- (6) pump 60 3000  
(HP) (yield gpm)  
0  
(type power)
- (7) electric log NO  
(yes or no)

(organization running log)

(8) how well bottom plugged steel plate


DRILLERS REMARKS:

RECEIVED  
FEB 18 1986

Department of Natural Resources  
Bureau of Land & Water Resources

If well telescopes please sketch and show depths.

GROUND LEVEL

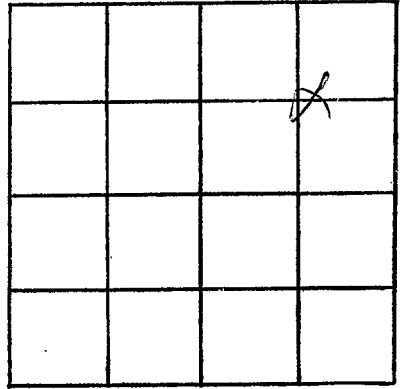

SECTION 12

Please indicate well location X.

ADDITIONAL INFORMATION

If more than one screen,  
show locations of each on sketch.