

MISSISSIPPI DEPARTMENT OF NATURAL RESOURCES

Bureau of Land and Water Resources

Southport Mall

P.O. Box 10631

Jackson, Mississippi 39209

WATER WELL DRILLERS LOG

Sharkey
D 2002

5/09
date well completed

1982 *Larry's well & pump*
firm name

Sharkey
county well located

LANDOWNER:	description of formations encountered	from	to
<i>J.C. Cooper</i>	<i>clay</i>	0	20
<i>Arguilla, Mo.</i> (mailing address)	<i>fine sand</i>	20	30
	<i>med S</i>	30	50
WELL LOCATION:	<i>med & coarse S</i>	50	100
sec. <u>6</u> T. <u>13</u> N R. <u>5</u> E S W	<i>coarse S & gravel</i>	100	150
<i>4 East</i> miles <i>2 1/2 W</i> of <i>Arguilla</i> (distance) (direction) (nearest town)	<i>clay</i>	150	225
WELL PURPOSE: (home, irrigation, municipal, industrial)	<i>clay & sand</i>	225	400
	<i>Sand</i>	400	450
	<i>clay & sand</i>	450	750
	<i>Sand</i>	750	810

WELL COMPLETION DATA: *140-4"*

- (1) diameter (inches) 4" x 2"
- (2) total depth (feet) 810'
- (3) static water level (feet) 22 below above
top of ground. *plastic*
- (4) casing 780, 780
(material) (depth)
(size) if telescope see back.
- (5) screen 30', 780'
(length) (depth to top)
2", plastic
(size) (material)
- (6) pump 1, 20
(HP) (yield gpm)
(type power)
- (7) electric log NO
(yes or no)
(organization running log)
- (8) how well bottom plugged _____

DRILLERS REMARKS:


DEPT. OF NATURAL RESOURCES
BUREAU OF LAND & WATER RESOURCES

SEP 15 1982

RECEIVED

If well telescopes please sketch and show depths.

GROUND LEVEL

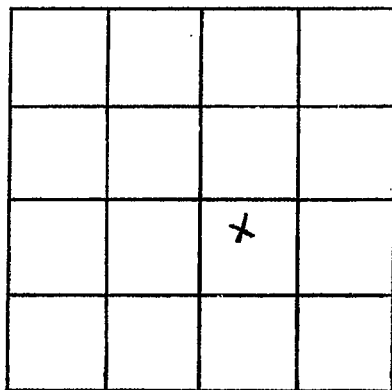

SECTION 6

Please indicate well location X.

ADDITIONAL INFORMATION

If more than one screen,
show locations of each on sketch.