

**MISSISSIPPI
BOARD OF WATER COMMISSIONERS**
416 North State Street
Jackson, Mississippi 39201

CODED

WATER WELL DRILLERS LOG

Sharkey
E15
2-67

2-7-1967 date well completed *Layne-Central Co.* firm name *Sharkey* county well located

LANDOWNER: *Town of Rolling Fork*
Rolling Fork, Miss.
(mailing address)

description of formations encountered	from	to
Clay	0	2
Sandy Clay	2	16
Blue Clay	16	50
Sand + Gravel	50	132

WELL LOCATION: *3 blocks east of city hall*
sec. 12 T 12 N S R 7 E W
(distance) miles _____ of _____ (direction) (nearest town)

Clay	132	206
Sand + Clay streaks	206	306
sand	306	459
Shale + Sand streaks	459	493
Hard Shale	493	530


WELL PURPOSE: *municipal*
(home, irrigation, municipal, industrial)

Rock	530	531
Shale + Sand streaks	531	561
Rock + Shale streaks	561	569
Shale + Sand streaks	569	644
Rock + Shale streaks	644	654
Shale streaks of sand	654	714
Sand + Shale	714	817
Hard Shale	817	820
Hard Shale, Gummu stks.	820	936
Sand + Shale streaks	936	974
sand	974	1029
Shale Break	1027	1029
Sand	1029	1041
Shale	1041	1042

WELL COMPLETION DATA:

- (1) diameter (inches) 10"
- (2) total depth (feet) 1045'
- (3) static water level (feet) 22 below top of ground.
- (4) casing Beh. Steel, 974' (material) (depth)
10" (size) if telescope see back.
- (5) screen 60', 979' (length) (depth to top)
6", Stainless steel (size) (material)
- (6) pump 40 (HP) (yield gpm)
Electric (type power)
- (7) electric log NO (yes or no)
(organization running log)
- (8) how well bottom plugged _____


CODED

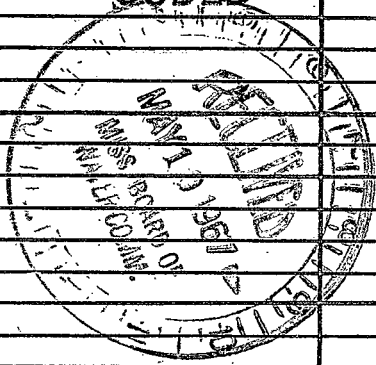

DRILLERS REMARKS:
NO CAPACITY TEST RUN AS OF THIS DATE

If well telescopes please sketch and show depths.

GROUND LEVEL

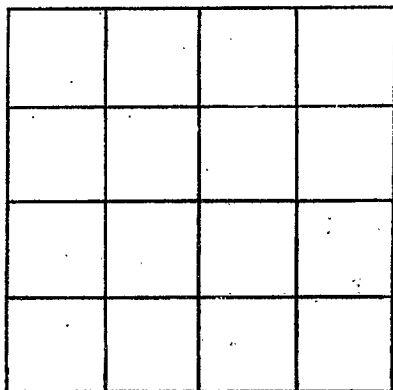

SECTION _____

Please indicate well location X.

ADDITIONAL INFORMATION

If more than one screen, show locations of each on sketch.