

Coded

MISSISSIPPI BOARD OF WATER COMMISSIONERS
416 North State Street
Jackson, Mississippi 39201

WATER WELL DRILLERS LOG

SHARKEY
E 17
4-1-74
E log #77
4-1-74

1974 JETCOAL Drilling Co.

Sharkey CODED

date well completed

firm name

county well located

LANDOWNER:

Council Band plantation
Rolling Fork, MS.
(mailing address)

WELL LOCATION:

sec. 23 T 12 N R 7 E
3 miles SE of Rolling Fork
(distance) (direction) (nearest town)

WELL PURPOSE:

(home) irrigation, municipal, industrial

WELL COMPLETION DATA:

- (1) diameter (inches) 4 1/2
- (2) total depth (feet) 987
- (3) static water level (feet) 126 below above top of ground.
- (4) casing steel (material), 150 (depth)
1 1/2 if telescope see back. (size)
- (5) screen 4 ft (length), 9 1/4 (depth to top)
2" (size), Stainless Steel (material)
- (6) pump 1 1/2 (HP), 20 (yield gpm)
Electric (type power)
- (7) electric log Yes (yes or no)
W.S. G.S. (organization running log)
- (8) how well bottom plugged 1/2 Prod

description of formations encountered

from

to

Clay and Top Soil	0	24
SAND	24	86
Gravel	86	184
Shale with Sand Blks	184	320
SAND	320	452
SANDY SHALE	452	516
SAND	516	556
Shale	556	656
SAND	656	712
Shale with Sand Blks	712	868
Shale	868	928
SAND	928	989
TOTAL	Depth	

CODED


APR 1 1974

DRILLERS REMARKS:

MISS. BUREAU OF WATER CONTROL

If well telescopes please sketch and show depths.

GROUND LEVEL

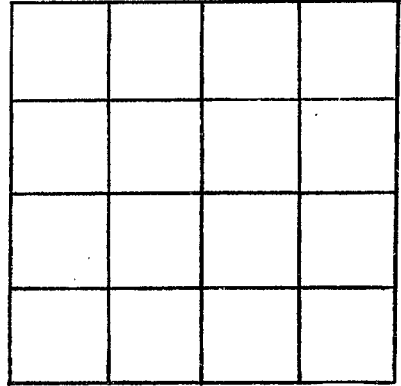

SECTION _____

Please indicate well location X.

ADDITIONAL INFORMATION

If more than one screen,
show locations of each on sketch.