

SHARKEY

E 18

Loc # 78

4-011-74

MISSISSIPPI BOARD OF WATER COMMISSIONERS  
416 North State Street  
Jackson, Mississippi 39201

CODED

WATER WELL DRILLERS LOG

4-11-

19

24 JetCoat Drilling Co

Sharkey

date well completed

firm name

county well located

LANDOWNER:

Council Bend plantation  
Rolling Fork, ms.  
(mailing address)

description of formations encountered

from

to

top soil & clay	0	35
shale	35	90
shale	90	180
clay	180	320
shale	320	450
shale	450	508
sand	508	548
shale	548	608
shale	608	706
sand & shale	706	860
shale	860	930
sand	930	980

WELL LOCATION:

sec. 23 T. 12 N. R. 7 E.  
S  
4 1/2 miles SE. of Rolling Fork  
(distance) (direction) (nearest town)

WELL PURPOSE:

(home, irrigation, municipal, industrial)

WELL COMPLETION DATA:

- (1) diameter (inches) 4 1/2"
- (2) total depth (feet) 989
- (3) static water level (feet) 20ft below top of ground.
- (4) casing Steel (material), 150ft (depth) <sup>790</sup> <sub>2ft</sub>
- 4x2 if telescope see back. (size)
- (5) screen 40 (length), 942 (depth to top)  
2" (size), Stainless Steel (material)
- (6) pump 1 1/2 (HP), 20 (yield gpm)  
electric (type power)
- (7) electric log YES (yes or no)
- MSMS Mechanical Supply (organization running log)
- (8) how well bottom plugged 2x1 inch  
under 18 steel rods

CODED

DECEMBER 1974  
MAR 1 8 1974

DRILLERS REMARKS:

drilled on  
back 300 feet away from  
this one but sand was  
to fine to set


MISS. BO. OF WATER COMMISSIONERS

If well telescopes please sketch and show depths.

113

113

GROUND LEVEL

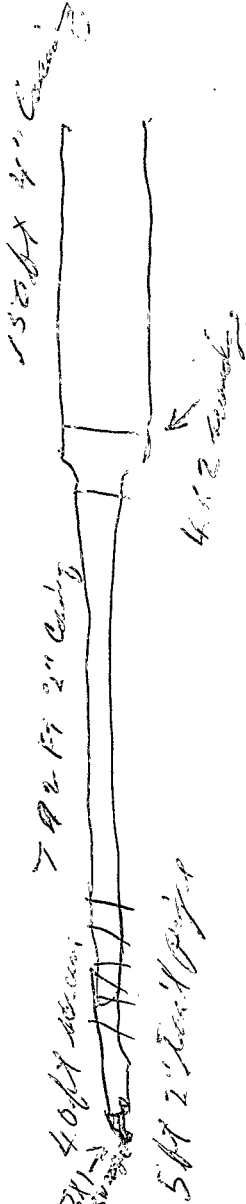


SECTION \_\_\_\_\_

Please indicate well location X.

ADDITIONAL INFORMATION

A series of horizontal lines provided for additional information, located below the "ADDITIONAL INFORMATION" header.

If more than one screen, show locations of each on sketch.