

SHARKEY
E19
3-15-74

MISSISSIPPI
 BOARD OF WATER COMMISSIONERS **CODED**
 416 North State Street
 Jackson, Mississippi 39201

WATER WELL DRILLERS LOG

3-15- 1974 JEF Coat Drilling Co. Sharkey
 date well completed firm name county well located

LANDOWNER: <u>Walker Agriculture</u> <u>208 martina ave</u> <u>Rolling Fork, ms.</u> (mailing address)	description of formations encountered	from	to
	<u>CLAY Topsoil</u>	<u>0</u>	<u>15</u>
	<u>SAND</u>	<u>15</u>	<u>80</u>
	<u>Gravel</u>	<u>80</u>	<u>100</u>
			<u>T.D.</u>
WELL LOCATION:			
sec. <u>10</u> T. <u>12</u> N. R. <u>7</u> E			
<u>1/2</u> miles <u>West</u> of <u>Rolling Fork</u>			
(distance) (direction) (nearest town)			
WELL PURPOSE: (home, irrigation, municipal, <u>Industrial</u>)			
WELL COMPLETION DATA:			
(1) diameter (inches) <u>2"</u>			
(2) total depth (feet) <u>100 FT.</u>			
(3) static water level (feet) <u>9 FT.</u> below top of ground.			
(4) casing <u>P.V.C.</u> , <u>88 FT.</u> (material) (depth)			
<u>2"</u> if telescope see back. (size)			
(5) screen <u>P.V.C. / P.A.R.</u> , <u>88 FT.</u> (length) (depth to top)			
<u>2"</u> , <u>P.V.C.</u> (size) (material)			
(6) pump <u>1/2</u> , <u>10 gpm</u> (HP) (yield gpm)			
<u>AS</u> (type power)			
(7) electric log (yes or <u>no</u>)			
(organization running log)			
(8) how well bottom plugged <u>Sand</u>			
<u>SHARKEY</u>			
DRILLERS REMARKS:			


CODED

RECORDED
 APR 26 1974

MISS.

If well telescopes please
sketch and show depths.

GROUND LEVEL

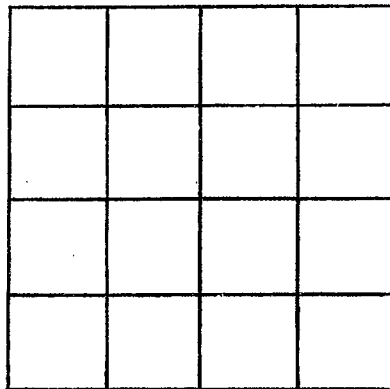

SECTION _____

Please indicate well location X.

ADDITIONAL INFORMATION

If more than one screen,
show locations of each on sketch.