

MISSISSIPPI
BOARD OF WATER COMMISSIONERS
416 North State Street
Jackson, Mississippi 39201

CODED

WATER WELL DRILLERS LOG

SHARKEY
E20
5-26-74

may 26, 74 1974 OVER WELL & IRRIGATION SERVICE **Sharkey**
date well completed firm name county well located

LANDOWNER:

Tom HARRIS
CARY, MISS
(mailing address)

description of formations encountered

	from	to
CLAY	0	21
FINE SAND	21	30
COARSE SAND	30	38
COARSE SAND	38	
PEARL RIVER GRAVEL		102

WELL LOCATION:

sec 31 T 12 N R 7 E
3 miles N.W. of CARY
(distance) (direction) (nearest town)

WELL PURPOSE: IRR.
(home, irrigation, municipal, industrial)


WELL COMPLETION DATA:

- (1) diameter (inches) 16"
- (2) total depth (feet) 102'
- (3) static water level (feet) 9' below top of ground.
- (4) casing PURTR, 62'
(material), (depth)
- 16"
(size) if telescope see back.
- (5) screen 40' 62'
(length), (depth to top)
- 16", BUTANE
(size), (material)
- (6) pump 60 3000
(HP), (yield gpm)
- BUTANE
(type power)
- (7) electric log N/O
(yes or no)

CODED

(organization running log)

(8) how well bottom plugged PLATE

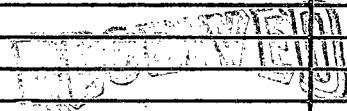


NOV 21 1974

DRILLERS REMARKS:

MISS. BD. OF WATER COMMISSIONERS

If well telescopes please sketch and show depths.

GROUND LEVEL

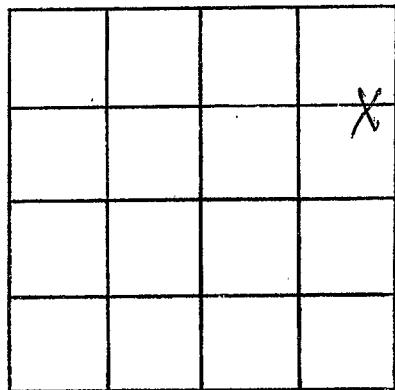

SECTION 31

Please indicate well location X.

ADDITIONAL INFORMATION

If more than one screen,
show locations of each on sketch.