

GW03639

Sharkey  
E 21  
4-29-75

MISSISSIPPI  
BOARD OF WATER COMMISSIONERS  
416 North State Street  
Jackson, Mississippi 39201

DED

WATER WELL DRILLERS LOG

Singer-Rayne  
Carter Brothers

April 29, 19 75 date well completed  
Carter Brothers firm name  
Sharkey county well located


LANDOWNER: Carter Brothers	description of formations encountered	from	to
Rollingfork, Mississippi			
(mailing address)	Clay	0	12'
WELL LOCATION:	Fine sand	12	42'
sec. <u>12</u> T <u>18</u> N R <u>7</u> W 150	Coarse sand	42	62'
<u>3</u> 12N East Rolling Fork	Coarse sand and gravel	62	112'
<u>1</u> <u>1/2</u> miles North of (distance) (direction) (nearest town)			
WELL PURPOSE: irrigation (home, irrigation, municipal, industrial)			
WELL COMPLETION DATA:			
(1) diameter (inches) <u>16"</u>			
(2) total depth (feet) <u>112'</u>			
(3) static water level (feet) <u>2</u> below top of ground.			
(4) casing <u>Steel</u> <u>62'</u> (material) (depth)			
<u>16"</u> if telescope see back. (size)			
(5) screen <u>50'</u> <u>50'</u> (length) (depth to top)			
<u>16"</u> <u>Steel</u> (size) (material)			
(6) pump <u>60HP</u> <u>2,800</u> (HP) (yield gpm)			
<u>engine</u> (type power)			
(7) electric log <u>no</u> (yes or no)			
<u>(organization running log)</u>			
(8) how well bottom plugged <u>steel plate</u>			
DRILLERS REMARKS:			

CODED

RECEIVED  
JUL 14 1975

If well telescopes please sketch and show depths.

GROUND LEVEL

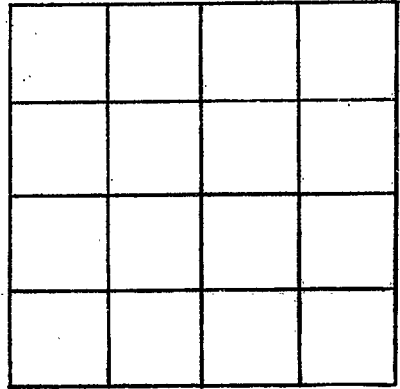

SECTION \_\_\_\_\_

Please indicate well location X.

ADDITIONAL INFORMATION

If more than one screen,  
show locations of each on sketch.