

SHARKEY  
E 24

MISSISSIPPI DEPARTMENT OF NATURAL RESOURCES  
Bureau of Land and Water Resources  
Southport Mall  
P.O. Box 10631  
Jackson, Mississippi 39209  
WATER WELL DRILLERS LOG

CODED  
10/11/84

9-1-84 date well completed  
19 IRRIGATION EQUIPMENT INC. firm name  
SHARKEY county well located

LANDOWNER: MOORE PLANTING CO  
BOX 209 CANY, MS  
(mailing address)

description of formations encountered	from	to
clay	0	30
sand + clay	30	40
sand	40	65
coarse sand	65	105

WELL LOCATION:  
sec. 23 T. 12 N R. 7 E  
S SW  
3 miles south of Rolling Fork  
(distance) (direction) (nearest town)

WELL PURPOSE: FISH POND  
(home, irrigation, municipal, industrial)

- WELL COMPLETION DATA:
- (1) diameter (inches) 16"
  - (2) total depth (feet) 105'
  - (3) static water level (feet) 19' below above top of ground.
  - (4) casing steel 65' (material) (depth)
  - (size) if telescope see back.
  - (5) screen 40' 65' (length) (depth to top)
  - 16" steel (size) (material)
  - (6) pump 60 3000 (HP) (yield gpm)
  - Diesel (type power)
  - (7) electric log (yes or no)
  - (organization running log)
  - (8) how well bottom plugged steel plate

CODED


DEPT. OF NATURAL RESOURCES  
BUREAU OF LAND & WATER RESOURCES

RECEIVED  
OCT 11 1984

DRILLERS REMARKS:

If well telescopes please sketch and show depths.

GROUND LEVEL

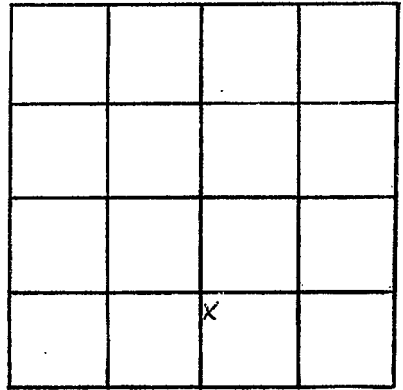

SECTION 23

Please indicate well location X.

ADDITIONAL INFORMATION

If more than one screen,  
show locations of each on sketch.