

**MISSISSIPPI DEPARTMENT OF NATURAL RESOURCES**  
**Bureau of Land and Water Resources**  
 Southport Mall  
 P.O. Box 10631  
 Jackson, Mississippi 39209  
**WATER WELL DRILLERS LOG**

CODED

SHARKEY  
E 26

8-30-84 19 IRRIGATION Equipment SHARKEY  
 date well completed firm name county well located

LANDOWNER: MOORE Planting Co.  
BOX 209 Camp MS  
 (mailing address)

description of formations encountered	from	to
<u>Clay</u>	<u>0</u>	<u>40</u>
<u>Sand + clay</u>	<u>40</u>	<u>55</u>
<u>Sand</u>	<u>55</u>	<u>65</u>
<u>Coarse sand</u>	<u>65</u>	<u>110</u>

WELL LOCATION:  
 sec. 23 T. 12 (N) R. 7 E (W)  
3 miles South of Rolling Fork  
 (distance) (direction) (nearest town)

WELL PURPOSE: Fish Pond  
 (home, irrigation, municipal, industrial)

WELL COMPLETION DATA:

(1) diameter (inches) 16"

(2) total depth (feet) 110'

(3) static water level (feet) 19 below above top of ground.

(4) casing Steel 75'  
 (material) (depth)  
 (size) if telescope see back.

(5) screen 40' 75'  
 (length) (depth to top)  
16" steel  
 (size) (material)

(6) pump 60 3000  
 (HP) (yield gpm)  
Diesel  
 (type power)

(7) electric log \_\_\_\_\_  
 (yes or no)  
 (organization running log)

(8) how well bottom plugged Steel  
PLATE

CODED


DEPT. OF NATURAL RESOURCES  
 BUREAU OF LAND & WATER RESOURCES

OCT 11 1984  
**RECEIVED**

DRILLERS REMARKS:

If well telescopes please  
sketch and show depths.

GROUND LEVEL

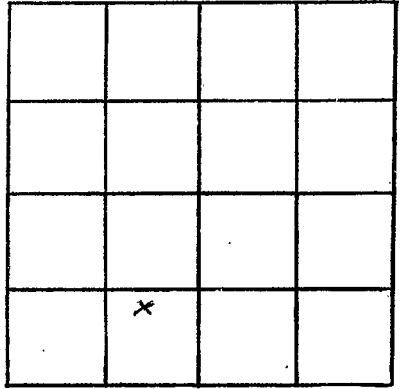

SECTION 23

Please indicate well location X.

ADDITIONAL INFORMATION

If more than one screen,  
show locations of each on sketch.