

MISSISSIPPI DEPARTMENT OF NATURAL RESOURCES

Bureau of Land and Water Resources

Southport Mall

P.O. Box 10631

Jackson, Mississippi 39209

WATER WELL DRILLERS LOG

Permit Applied For E 27

5-14-88 date well completed

88 Dyer Well firm name

Sharkey county well located

LANDOWNER

Curtis Briss

description of formations encountered

from

to

Box 458

Clay

0 48

Rolling Fork 39159 (mailing address)

fine sand

48 68

M Sand & Gravel

68 92

fine sand

92 95

Sand & Gravel

95 115

WELL LOCATION:

sec 12 T 12 N R 7 E

2 miles S Rolling Fork (distance) (direction) (nearest town)

WELL PURPOSE: Irrigation (home, irrigation, municipal, industrial)

WELL COMPLETION DATA:

(1) diameter (inches) 16"

(2) total depth (feet) 115'

(3) static water level (feet) below top of ground.


(4) casing steel (material), (depth) 16" (size) If telescope see back.

(5) screen 40' (length), (depth to top) 16" (size) (material)

(6) pump 40 (HP), (yield gpm) Gear (type power)

(7) electric log No (yes or no) None (organization running log)

(8) how well bottom plugged Plate

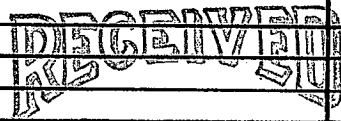


JUN 06 1988

Department of Natural Resources Bureau of Land & Water Resources

DRILLERS REMARKS:

If well telescopes please sketch and show depths.

GROUND LEVEL

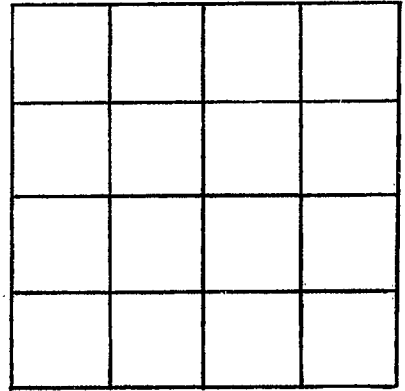

SECTION \_\_\_\_\_

Please indicate well location X.

ADDITIONAL INFORMATION

If more than one screen,  
show locations of each on sketch.