

9/16/69
JM
C2985

MISSISSIPPI
BOARD OF WATER COMMISSIONERS
416 North State Street
Jackson, Mississippi 39201
WATER WELL DRILLERS LOG

Sharkey
E 44
9-8-69


September 8, 1969 Layne-Central Company Sharkey
date well completed firm name county well located

LANDOWNER:	description of fomations encountered	from	to
Mississippi State Game & Fish Commission	Clay	0	20
	Coarse sand	20	40
Jackson, Mississippi	Coarse sand, pea gravel	40	85
(mailing address)	Coarse sand, pea gravel & gravel	85	104
WELL LOCATION: NE, NE	Clay		104
sec. 16 T. 12N N R. 7 X E W Fork			
1 miles So of Rolling			
(distance) (direction) (nearest town)			
WELL PURPOSE: irrigation			
(home, irrigation, municipal, industrial)			
WELL COMPLETION DATA:			
(1) diameter (inches) 16			
(2) total depth (feet) 104			
(3) static water level (feet) 11' below top of ground.			
(4) casing steel, 54' (material), (depth), 16" (size) If telescope see back.			
(5) screen 50' (length), 104' (depth to top), 16" (size), Armc0 (material)			
(6) pump 60 (HP), 3,000 (yield gpm), electric (type power)			
(7) electric log no (yes or no)			
(organization running log)			
(8) how well bottom plugged plate			
DRILLERS REMARKS:			

SEP 19 1969
MISSISSIPPI BOARD OF WATER COMMISSIONERS

If well telescopes please sketch and show depths.

GROUND LEVEL

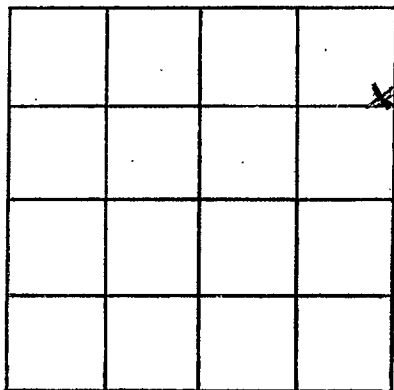

SECTION 16

Please indicate well location X.

ADDITIONAL INFORMATION

If more than one screen, show locations of each on sketch.