

SHARKEY  
~~CITRE~~  
 4/26/78

MISSISSIPPI  
 BOARD OF WATER COMMISSIONERS  
 47 416 North State Street  
 Jackson, Mississippi 39201

CODED

WATER WELL DRILLERS LOG

April 26 1978 Dyer Well & Irrigation Sharkey  
 (date well completed) (firm name) (county well located)

LANDOWNER: Carter Brothers  
 Rolling Fork, Miss. 39154  
 (mailing address)  
 WELL LOCATION:  
 sec. 3 T. 13 N. R. 2 E  
 S W  
 2 miles West of Rolling Fork  
 (distance) (direction) (nearest town)

description of formations encountered	from	to
Clay	0	13
Clay	14	23
Clay	24	36
FINE SAND	37	43
FINE SAND	44	53
FINE SAND	54	58
SAND + GRAVEL	59	113

WELL PURPOSE: Irrigation  
 (home, irrigation, municipal, industrial)

Bottom 113/

WELL COMPLETION DATA:  
 (1) diameter (inches) 16"  
 (2) total depth (feet) 113'  
 (3) static water level (feet) 16' below top of ground.  
 (4) casing STEEL, 73' (material) (depth)  
 16" If telescope see back. (size)  
 (5) screen 40', 73' (length) (depth to top)  
 16", STEEL (size) (material)  
 (6) pump 60, 3000 (HP) (yield gpm)  
 Diesel (type power)  
 (7) electric log No (yes or no)

CODED

(organization running log)  
 (8) how well bottom plugged Plate

Miss. Board of Water Comm.


DRILLERS REMARKS:

FEB 8 1978

RECEIVED

If well telescopes please sketch and show depths.

GROUND LEVEL

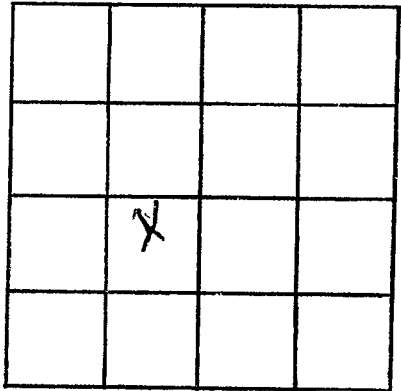

SECTION 2

Please indicate well location X.

ADDITIONAL INFORMATION

Lined area for additional information.

If more than one screen, show locations of each on sketch.