

SHARKEY
E 49
3/3/78

MISSISSIPPI
BOARD OF WATER COMMISSIONERS
416 North State Street
Jackson, Mississippi 39201

CODED

WATER WELL DRILLERS LOG

3-3 1978 E.M. "Bud" Cresswell Sharkey
date well completed firm name county well located

LANDOWNER:
Wilson Varden
Rolling Fork, Mo.
(mailing address)

description of formations encountered	from	to
Surface Deposits	0	20
Bank - gravel	20	90

WELL LOCATION:
sec. 2 T 12 N R 7 E
In Rolling Fork (W)
(distance) miles (direction) of (nearest town)

WELL PURPOSE: Home
(home, irrigation, municipal, industrial)

- WELL COMPLETION DATA:
- (1) diameter (inches) 2
 - (2) total depth (feet) 90
 - (3) static water level (feet) 18 below top of ground above
 - (4) casing PVC 85 (material) (depth)
2 (size) if telescope see back.
 - (5) screen 5 85 (length) (depth to top)
2 PVC (size) (material)
 - (6) pump 1 10 (HP) (yield gpm)
0 (type power)
 - (7) electric log No (yes or no)
- (organization running log)

how well bottom plugged
Cush work value

DRILLERS REMARKS:


CODED

RECEIVED

MAR 22 1978

If well telescopes please sketch and show depths.

GROUND LEVEL

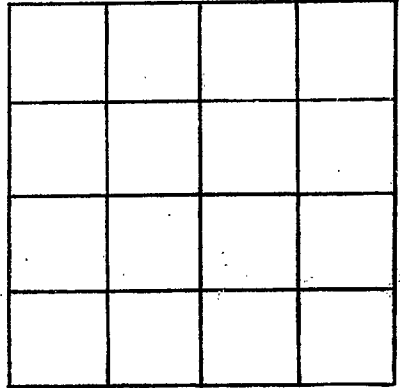

SECTION _____

Please indicate well location X.

ADDITIONAL INFORMATION

If more than one screen, show locations of each on sketch.