

| |
|----------|
| SHARKLEY |
| E 50 |
| 3-01-79 |

MISSISSIPPI
 BOARD OF WATER COMMISSIONERS
 416 North State Street
 Jackson, Mississippi 39201

CODED

WATER WELL DRILLERS LOG

March 1, 1979 E.M. "Bud" Cresswell Sharkley
 date well completed firm name county well located

LANDOWNER:
 Jack Walton
 Mylesville, Ms.
 (mailing address)

| description of formations encountered | from | to |
|---------------------------------------|------|-----|
| Clay | 0 | 30 |
| Sand/gravel | 30 | 110 |

WELL LOCATION:
 sec. 17 T. 12 N R. 7 E
 5 miles West Rolling Fork
 (distance) (direction) (nearest town)

WELL PURPOSE: home
 (home, irrigation, municipal, industrial)

WELL COMPLETION DATA:

(1) diameter (inches) 2

(2) total depth (feet) 110

(3) static water level (feet) 15 below top of ground.

(4) casing PVC, 100 (material) (depth)
 2 (size) if telescope see back.

(5) screen 10, 100 (length) (depth to top)
 2, PVC (size) (material)

(6) pump 1, 10 (HP) (yield gpm)
 0 (type power)

(7) electric log No (yes or no)

(organization running log)

(8) how well bottom plugged
 Steel plug

DRILLERS REMARKS:

CODED


Miss. Board of Water Comm.

MAR 13 1979

RECEIVED

If well telescopes please sketch and show depths.

GROUND LEVEL

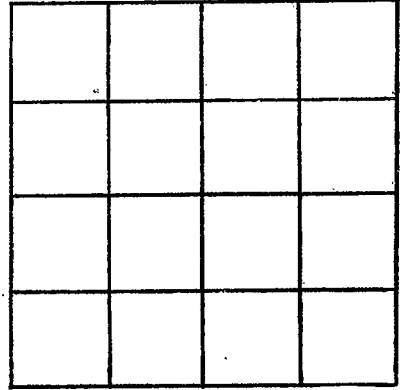

SECTION _____

Please indicate well location X.

ADDITIONAL INFORMATION

If more than one screen,
show locations of each on sketch.