

MISSISSIPPI DEPARTMENT OF NATURAL RESOURCES

Bureau of Land and Water Resources

Southport Mall

P.O. Box 10631

Jackson, Mississippi 39209

WATER WELL DRILLERS LOG

CODED

SHARKEY
E 51

10-1-1984
date well completed

Schultz Drilling
firm name

Sharkey
county well located

LANDOWNER:

DR. Jackson
Rolling Fork, MS
(mailing address)

description of formations encountered

from to

CLAY	0	20
COARSE SAND	20	100
COARSE SAND + GRAVEL	100	140
CLAY	140	180
Lignite	180	188
Shale	188	340
Fine to MED. SAND	340	420
Shale	420	560
Shale	560	600
SAND	600	660
CLAY	660	780
SAND & clay	780	840
FINE SAND	840	940
SAND	940	1000
SANDY CLAY	1000	1100

WELL LOCATION:

sec. 8 T. 35^N R. 6 E
2 miles (distance) S^W of Rolling Fork (nearest town)

WELL PURPOSE: Home
(home, irrigation, municipal, industrial)

WELL COMPLETION DATA:

- (1) diameter (inches) 4" X 2"
- (2) total depth (feet) 995'
- (3) static water level (feet) 31' below top of ground.
- (4) casing GALV. 975' (material) (depth)
- _____ (size) if telescope see back.
- (5) screen 20' 975' (length) (depth to top)
- 2" stainless (size) (material)
- (6) pump 1 1/2 25 (HP) (yield gpm)
- ele (type power)
- (7) electric log NO (yes or no)
- X (organization running log)
- (8) how well bottom plugged b/w

DRILLERS REMARKS:


CODED

DEPT. OF NATURAL RESOURCES
BUREAU OF LAND & WATER RESOURCES

NOV 26 1984

RECEIVED

If well telescopes please sketch and show depths.

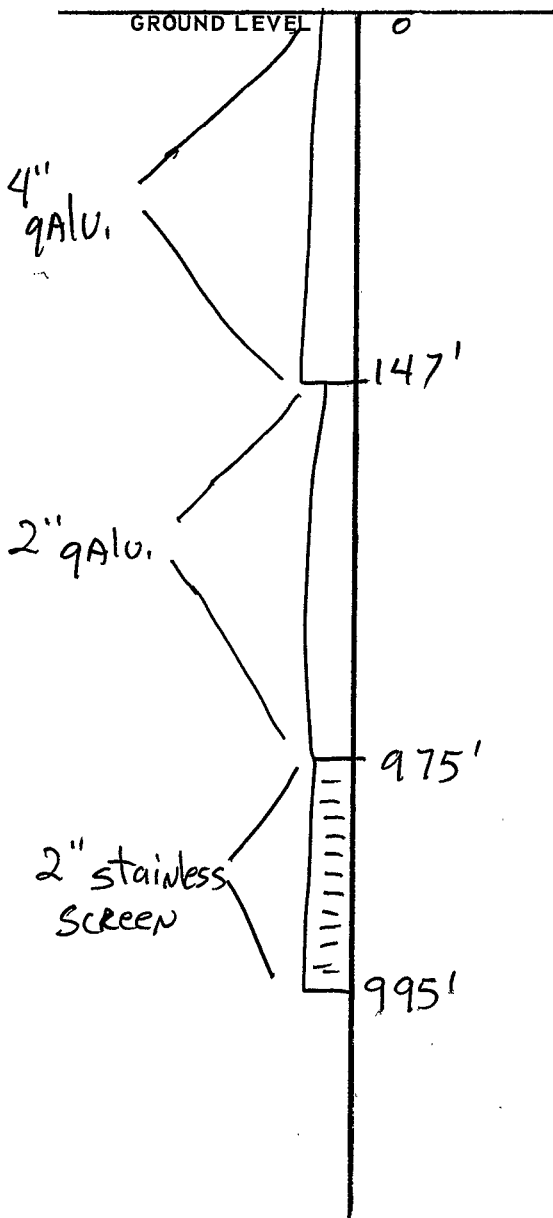

		X	

SECTION 8

Please indicate well location X.

ADDITIONAL INFORMATION

Hole was Drilled to
1100' Bottom 100' SANDY
CLAY

If more than one screen,
show locations of each on sketch.