


SHARKEY  
 22-3486  
E 52

Coded

MISSISSIPPI DEPARTMENT OF NATURAL RESOURCES  
 Bureau of Land and Water Resources  
 Southport Mall  
 P.O. Box 10631  
 Jackson, Mississippi 39209  
**WATER WELL DRILLERS LOG**

2-17-19 87 LAYNE-CENTRAL CO. SHARKEY  
 date well completed firm name county well located

LANDOWNER:	description of formations encountered	from	to
CITY OF ROLLING FORK P.O. BOX 310 ROLLING FORK, MS 39169 (mailing address)			
WELL LOCATION: sec. <u>11</u> T- <u>12</u> N R- <u>7</u> E IN TOWN BY CARE INN (distance) miles (direction) of (nearest town)	CLAY	7	33
	FINE SAND	23	53
WELL PURPOSE: MUNICIPAL (home, irrigation, municipal, industrial)	MED. COARSE SAND	53	85
	COARSE SAND & P.GRAVEL	85	98
WELL COMPLETION DATA: (1) diameter (inches) <u>10"</u> (2) total depth (feet) <u>1164'9"</u> (3) static water level (feet) <u>33'</u> below top of ground. (4) casing <u>STEEL</u> <u>1113'</u> (material) (depth) <u>10"</u> if telescope see back. (size) (5) screen <u>45'9"</u> <u>1113'</u> (length) (depth to top) <u>6"</u> ST.ST. BAR WELD (size) (material) (6) pump <u>30</u> <u>350</u> (HP) (yield gpm) ELECTRIC (type power) (7) electric log <u>YES</u> (yes or no) LAYNE GEOLOGICAL SERVICE (organization running log) (8) how well bottom plugged <u>6"BP VALVE</u>	SAND & GRAVEL	98	149
	CLAY	149	186
	SAND -STKS.OF CLAY	186	260
	SAND	260	446
	CLAY	446	531
	SANDY CLAY & STKS.OF SAND	531	599
	CLAY	599	749
	SANDY CLAY & STKS.OF SAND	749	786
	CLAY	786	978
	SAND	978	997
	CLAY	997	1012
	SAND	1012	1030
	SANDY CLAY	1030	1070
	SAND	1070	1092
	CLAY	1092	1115
	SAND	1115	1164
	CLAY	1164	1166
	SANDY CLAY	1166	1189

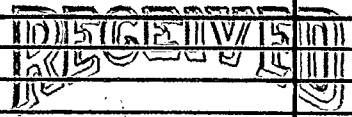


FEB 01 1988

Department of Natural Resources  
 Bureau of Land & Water Resources

DRILLERS REMARKS:

If well telescopes please sketch and show depths.

GROUND LEVEL

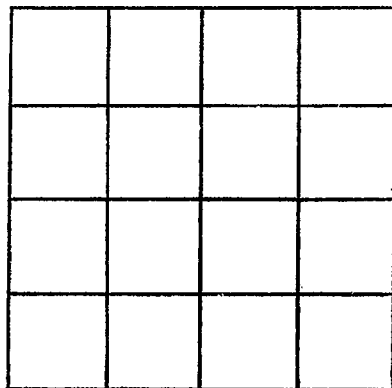

SECTION \_\_\_\_\_

Please indicate well location X.

ADDITIONAL INFORMATION

If more than one screen, show locations of each on sketch.