County: Sharkey Permit #: GW-49236	P Drill	ELL REPORT art 1 er's Log	For Office Use Only:         Well #:       95         Aquifer:
Driller: Irrigation Equipment, Inc. Date drilling completed: 6-9-16	Office of Land a P.O. Jackson, M (601)	nt of Environmental Quality nd Water Resources Box 2309 /IS 39225-2309 961-5210 i0-0535 (fax)	E-Log #:
State Law requires that this report a Department at the above address w			
Well Owner Informa	ation		Borehole Location
( <i>Landowner if borehole is not fo</i> Owner Name: <b>Carter Brothers Inc.</b>		Latitude: 32 52' 27.3"	Longitude: 90 56' 14.3"
Mailing Address: PO Box 458			one): Conventional Survey,
	······	1 6	eld GPS, 🗌 Survey-grade GPS
Rolling Fork MS City Stat	39159 te Zip code	JW K NE	_ ¼, Sec <u>20</u> T <u>12N</u> R <u>7W</u>
Telephone No. () -			W of Rolling Fork (Nearest Town)
	Well / Bore	hole Data	
Date drilling started: 6-9-16	Date drilling completed: 6	9-16 Hole depth: 1	18' Hole diameter: 24"
Location of the source of any surface wat	ter used for drilling:	rface Water	
Method of dosing and volume of Chlorine	e used in drilling and devel	opment: 50 PPM	
Logs run (check all applicable): 🛛 No log	g run 🔲 Electric 🗍 Gamm	ia Ray 🗍 Density 🗍 Sonic	Neutron D Other:
Name of organization running log(s):			
Purpose of borehole (check one): 🛛 W			
	Seismic Survey 🔲 O	ther ( <b>describe</b> )	
	-	truction, skip the remain	
Purpose of Well (check all applicable):	] Home 🗍 Industrial 🗍 Pu	blic Supply 🛛 Irrigation 🗂 F	ish Culture
If a flowing well, method of flow regulation			
Static Water Level: _13 fi			
Method of Measurement (check one)	Steel tape 🗌 Electric tape	Air line 🗌 Other: (desci	ibe)
Well depth: _118' Well grouted to a	depth of: <u>10</u> feet	Type of grout (check one):	🗆 Neat Cement 🖾 Bentonite 📋 Mix
Casing length: 78 feet	Casing diameter: 16	inches Type	of casing: PVC
Screen length: 40 feet	Screen diameter: 16	inches Type	of screen: PVC
		rom 7978	feet to 118 feet
Screen slot size:050 in	nches Setting depth:		
			a perconti
Type of completion (check all applicable)			ceived
Type of completion (check all applicable)  Other (describe):  Top of lap pipe or reduction in casing:	: 🖾 Gravel packed 🗌 Und		UN 29 2016

Form provided by Forms On-A-Disk · 214-340-9429 · FormsOnADisk.com

•


	For	Office	Use Only:	
Well #:	Ĕ	98	Use Only:	

The sketch below only required for water wells

## If well telescopes, show depths on sketch.

County: Sharkey
Permit #: GW-49236

.

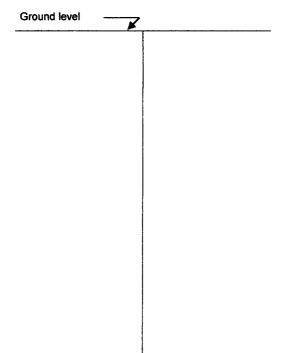

<u>Description of formations encountered must be provided for all wells</u> and boreholes, unless specifically exempted by regulations

Description of Formations Encountered	From (depth)	To (depth)
Clay	Ground level	37
Fine Sand	38	61
Fine Sand & Gravel	62	65
Med. Sand & Gravel	66	116
Clay	117	118
·····		
		1
	<u> </u>	
		1
· · · · · · · · · · · · · · · · · · ·		
	<u> </u>	
	l	

If more than one screen, show location of each on sketch

Sketch the property layout and include the following:

1) the well location	on	-	
2) any permaner	nt structures on the pr	roperty that may aid	I in locating the well

3) any roads, power lines, or other items that may aid in locating the property and the we	3)	any roads,	power lines,	or other	items that	t may aid	d in locating	g the	property	y and th	e we
--	----	------------	--------------	----------	------------	-----------	---------------	-------	----------	----------	------

4) a north arrow

		Received
		By ULWR
Landowner Name:		
I HEREBY CERTIFY that the well/borehole was drilled, con requirements of the Mississippi Department of Environment if applicable, and state laws.		
0695	6-24-16	
Print Name of Responsible Licensee and License No.	Date	Signature of Licensee
		Form: OLWR-SWR-1A (4/13)

[		ELL REPORT	For Office Use Only			
County: Sharkey	1	Part 2	For Office Use Only:			
Permit #: GW-49236		s Completion Report				
Driller: Irrigation Equipment, Inc.	Mississippi Departme	nt of Environmental Quality	Aquifer:			
Date drilling completed: 6-9-16	P.O.	Box 2309				
Copy information from block on Part 1		MS 39225-2309 ) 961-5210				
		60-0535 (fax)				
This part of the report must be completed of the report must be attached and both Well Owner Informa	parts filed with the Depart	ment at the above address wit				
Owner Name: Carter Brothers Inc		Latitude: 32 52' 27.3"	Longitude: <b>90_56'_14.3''</b>			
Mailing Address: PO Box 458		Method of Lat/Long (check o	ne): 🔲 Conventional Survey,			
			ld GPS, 🔲 Survey-grade GPS			
Rolling Fork MS	39159	SW 1/ NE	¼, Sec <u>20</u> T <u>12N</u> R <u>7W</u>			
City State						
Telephone No. () -		Miles SV (Distance) (Direc	N of <b>TW</b> tion) (Nearest Town)			
	Pump Type	(check one)				
🗇 Submersible 🖾 Turbine 🗖 Air Lift 🔲 C	entrifugal 🔲 Flowing We	II 🔲 Jet 🛄 Piston 🛄 Rotary [	] Other (describe):			
Date Pump Installed 6-10-16	Ra	ated Pump Capacity: 2100+/	- Gallons Per Minute			
Is This Pump (check one): 🛛 New 🗌 Re	paired 🗌 Replacement					
	•••	(check one)				
Electric 🛛 Diesel 🗋 Gasoline 🗌 Natur						
Horse Power Rating of Motor: 60	Setting Depth:	70 feet N	lumber of Stages: 1			
	Pump Test Data for	Non Flowing Well	······································			
Date Well Tested:		-	num 4 hours): Hours			
Static Water Level (A): Fe	et Below Land Surface					
Drawdown [(B) - (A)]: Feet Below Land Surface Test Pumping Rate: Gallons Per Minute Method of measurement (check one): Steel tape [] Electric tape [] Air line [] Other (describe):						
Pump Test Data for Flowing Well						
Measured shut in head:	Feet	-				
Well yielded GPM with a	a drawdown of	feet after	hours of pumping			
Meter Installation						
Meter Manufacturer:		<b>m</b>	eceived			
Meter Model Number/Name:						
Totalizer Register Unit and Multiplier Fac			ILIN 2 9 2016			
	Meter installed by:					
Is This Meter (check one): New Re		E	By OLWR			
Important: By submitting the above information you are certifying that this meter was installed to manufacturer standards. For agricultural wells, a list of approved meters is on the MDEQ website.						
I HEREBY CERTIFY that the above statements are true to the best of my knowledge.						
0695		6-24-16	2			
Print Name of Pump Installer and Licer	ise No. (if applicable)	Date	Signature of Pump Installer			

Form: OLWR-SWR-1B (4/13)

.