

Sharkey
E 2000

MISSISSIPPI DEPARTMENT OF NATURAL RESOURCES
Bureau of Land and Water Resources
Southport Mall
P.O. Box 10631
Jackson, Mississippi 39209
WATER WELL DRILLERS LOG

2-22 1984 date well completed
Schultz Drilling Sharkey firm name county well located

LANDOWNER:
CARTER FARMS
Rolling Fork, MS
(mailing address)

description of formations encountered	from	to
	Clay COARSE SAND	0 40

WELL LOCATION:
sec. 13 T 12 N R 7 E
S S of Rolling Fork
(distance) (direction) (nearest town)

WELL PURPOSE: Irrigation
(home, irrigation, municipal, industrial)


- WELL COMPLETION DATA:
- (1) diameter (inches) 2"
 - (2) total depth (feet) 80'
 - (3) static water level (feet) 16' below above top of ground.
 - (4) casing PVC 60'
(material) (depth)
 if telescope see back.
(size)
 - (5) screen 10' 60'
(length) (depth to top)
2" PVC
(size) (material)
 - (6) pump Ø
(HP) (yield gpm)
Ø
(type power)
 - (7) electric log Ø
(yes or no)
Ø
(organization running log)
 - (8) how well bottom plugged CAP

DRILLERS REMARKS:

DEPT. OF NATURAL RESOURCES
BUREAU OF LAND & WATER RESOURCES
MAR - 6 1984
RECEIVED

If well telescopes please sketch and show depths.

GROUND LEVEL

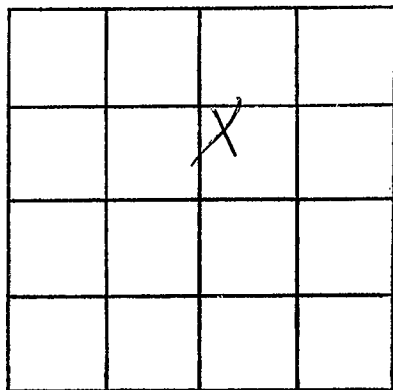

SECTION 13

Please indicate well location X.

ADDITIONAL INFORMATION

If more than one screen,
show locations of each on sketch.