

MISSISSIPPI DEPARTMENT OF ENVIRONMENTAL QUALITY  
Office of Land and Water Resources

**RECEIVED**

DEC 02 1999 P. O. Box 10631  
Jackson, MS 39289-0631  
WATER WELL DRILLERS LOG

COUNTY WELL LOCATED  
Sharkey

WELL NUMBER E 2012 CODED

DATE WELL COMPLETED  
10/27/99  
10-27-99

PERMIT NUMBER

NAME OF DRILLING FIRM  
Schudico Ltd

NAME & MAILING ADDRESS OF LANDOWNER  
Jimmy Goad

Rolling Fork MS

39159

WELL LOCATION: SEC 27 TOWNSHIP 12 RANGE 7 S E

DISTANCE 3 1/2 Miles DIRECTION South of NEAREST TOWN Rolling Fork

OTHER LANDMARK

WELL PURPOSE Home Irrigation, Municipal, Industrial, Fish Pond, etc.

Dept. of Environmental Quality  
Office of Land & Water Resources

PUMP TYPE (Circle One):  
Submersible, Turbine, Jet, Flowing Well,  
Other (Describe)

POWER TYPE (Circle One):  
Electric, Tractor, Diesel, Gasoline, Butane,  
Other (Describe) H/P 1/2

Pump Capacity (GPM) 12 No. of Stages 5 Setting Depth 80 FT.

PUMP TEST

Well yielded \_\_\_\_\_ GPM with  
a drawdown of \_\_\_\_\_ ft.  
after \_\_\_\_\_ hours of pumping

WELL DATA

Well Depth <u>100</u>	Casing Diameter (In.) <u>4</u>	Casing Length (Ft.) <u>80</u>
Type of Casing <u>pvc</u>	Hole Depth <u>100</u>	Depth to Static Water Level <u>12</u>

TYPE OF COMPLETION: (Circle One or More):  
Gravel Packed, Underreamed, Telescoped,  
Natural Development, Open Hole, Other

WELL GROUTED TO A DEPTH OF 10 FEET  
Type Grout (circle one): Cement, Bentonite, or Mix

LOG DATA

TYPE OF LOG RUN (Circle One):  
Electric, Gamma Ray, Density, Sonic, No Log Run, Neutron,  
Other (Describe)

Name of Organization Running Log

SCREEN DATA

Diameter - Inches <u>4</u>	Length - Feet <u>20</u>	Slot Size - Inches <u>.010</u>
Screen Type <u>pvc</u>	Depth to Bottom - Feet <u>100</u>	

GEOLOGIC DATA (Office Use Only)

Surface Elev.	Geologic Unit	Unit Thickness	Depth to Top
Subs. SWL	Date	Analysis	Aquifer Test


Driller's Remarks

DESCRIPTION OF FORMATIONS ENCOUNTERED	FROM	TO	FORMATIONS (Continued)	FROM	TO
<u>Gumbo</u>	<u>0</u>	<u>40</u>			
<u>sand &amp; coarse sand</u>	<u>40</u>	<u>100</u>			

IF MORE SPACE IS NEEDED, USE BACK

If well telescopes please sketch and show depths.

GROUND LEVEL

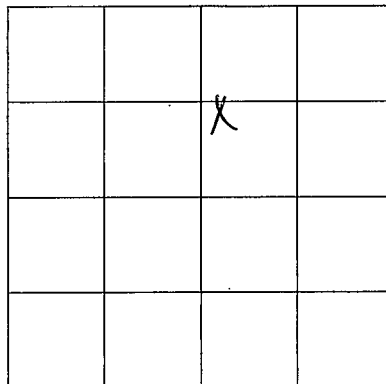

SECTION 27

Please indicate well location X.

ADDITIONAL INFORMATION

If more than one screen,  
show location of each on sketch.