

Sharkey  
F6  
4-14-76  
Elyth 86

MISSISSIPPI  
BOARD OF WATER COMMISSIONERS  
416 North State Street  
Jackson, Mississippi 39201

CODED

WATER WELL DRILLERS LOG

4/14/76 1976 date well completed  
F. M. "Bud" CRESSWELL firm name  
SHARKEY county well located

LANDOWNER:  
Moore Planting Co.  
CARY, MS.  
(mailing address)

description of formations encountered	from	to
Clay	0	15
Sand-gravel	15	162
Sand	162	200
Shale	200	280
Sand	280	480
Shale	480	945
Sand	945	1010

WELL LOCATION:  
sec. 20 T 12 N R 6 E  
2 miles EAST of Rolling Fork  
(distance) (direction) (nearest town)

WELL PURPOSE: FARM  
(home, irrigation, municipal, industrial)

WELL COMPLETION DATA:

(1) diameter (inches) 4

(2) total depth (feet) 1010

(3) static water level (feet) 18 below above top of ground.

(4) casing Steel 180 (material) (depth)  
4 (size) If telescope see back.

(5) screen 40 970 (length) (depth to top)  
2 STAINLESS (size) (material)

(6) pump 1 1/2 30 (HP) (yield gpm)  
0 (type power)

(7) electric log yes (yes or no)  
State (organization running log)

(8) how well bottom plugged  
Steel plug

DRILLERS REMARKS:


CODED

MAY 12 1976

MISS. BD. OF WATER COMMISSIONERS

If well telescopes please sketch and show depths.

GROUND LEVEL

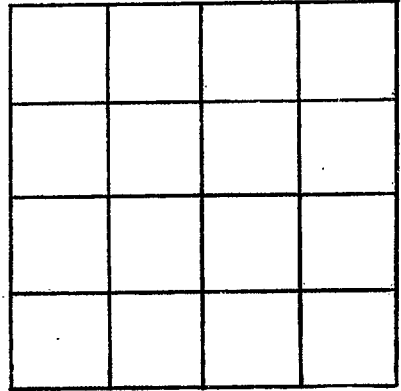

SECTION \_\_\_\_\_

Please indicate well location X.

ADDITIONAL INFORMATION

If more than one screen, show locations of each on sketch.