




If well telescopes please sketch and show depths.

GROUND LEVEL

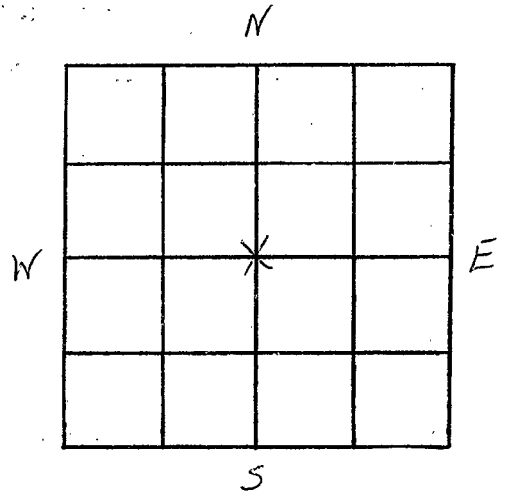

SECTION 20

Please indicate well location X.

**ADDITIONAL INFORMATION**

Well is centered on the west  
80 of the Southeast 160 of  
section 20.

If more than one screen,  
show locations of each on sketch.