

**SHARKEY**  
**F9**  
**8-2-79**

MISSISSIPPI  
 BOARD OF WATER COMMISSIONERS  
 416 North State Street  
 Jackson, Mississippi 39201 **CODED**

**WATER WELL DRILLERS LOG**

**BUTANE GAS COMPANY**

**8-2-79** 19  
 date well completed

**SHARKEY**  
 county well located

**OF GREENWOOD**

LANDOWNER:	description of formations encountered	from	to
<b>Ronald HARGRAVE</b>			
<b>Rolling Fork</b> (mailing address)	SAND	18	60
<b>WELL LOCATION:</b>	SAND + GRAVEL	60	145
sec. <b>27</b> T <b>12</b> N R. <b>6</b> E S. <b>6</b> W	CLAY	145	185
<b>6</b> miles <b>SE</b> of <b>Rolling Fork</b>	SAND + Clay	185	210
(distance) (direction) (nearest town)	SAND	210	270
<b>WELL PURPOSE:</b> <b>Home</b>	SAND + SHALE	270	340
(home, irrigation, municipal, industrial)	SHALE	340	390
<b>WELL COMPLETION DATA:</b>	SAND	390	450
(1) diameter (inches) <b>4 1/2</b>	SHALE + SAND	450	470
(2) total depth (feet) <b>807</b>	SAND	470	530
(3) static water level (feet) <b>28</b> below top of ground.	SANDY SHALE	530	585
(4) casing <b>Steel</b> , <b>787</b> , (material), (depth), <b>KK</b> if telescope see back. (size)	FINE SAND + SHALE	585	700
(5) screen <b>20</b> , <b>787</b> (length), (depth to top) <b>2"</b> , <b>Stainless</b> (size), (material)	Gummy SHALE	700	765
(6) pump <b>1</b> , <b>20</b> (HP), (yield gpm) <b>Elec</b> (type power)	SAND	765	815
(7) electric log <b>NO</b> (yes or no)  (organization running log)			
(8) how well bottom plugged <b>BACK PRESSURE VALVE</b>			
<b>DRILLERS REMARKS:</b>			

**CODED**

Miss. Board of Water Comm.

SEP 4 1979

**RECEIVED**


If well telescopes please sketch and show depths.

GROUND LEVEL

105' - 4" CASING →

682' - 2" CASING →

70' - 2" SCREEN →

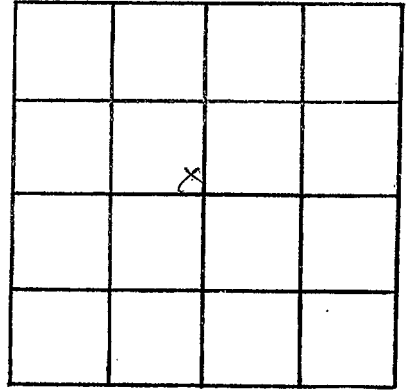

SECTION 27

Please indicate well location X.

ADDITIONAL INFORMATION

If more than one screen,  
show locations of each on sketch.