

Sharkey
 F13
 7-21-81

MISSISSIPPI DEPARTMENT OF NATURAL RESOURCES
 Bureau of Land and Water Resources
 Southport Mall
 P.O. Box 10631
 Jackson, Mississippi 39209
WATER WELL DRILLERS LOG

CODED

July 21 19 81 date well completed
 Bruce Berryman firm name
 Greenwood
 SHARKEY county well located

LANDOWNER: Nick's Flying Service
 description of formations encountered
 Clay from 0 to 20
 Sand & Gravel from 20 to 100
 P.O. Box 309
 Rolling Fork, MS 39159
 (mailing address)

WELL LOCATION:
 sec. 7 T. 12 N. R. 6 E. S. 5
 2 miles E of Rolling Fork.
 (distance) (direction) (nearest town)

WELL PURPOSE: AIRPORT
 (home, irrigation, municipal, industrial)

WELL COMPLETION DATA:

- (1) diameter (inches) 4"
- (2) total depth (feet) 100'
- (3) static water level (feet) 15' below top of ground.
- (4) casing 4" PVC, 80' (material) (depth)
 (size) If telescope see back.
- (5) screen 20' (length), 80' (depth to top)
 4" 010, P.V.C. (size) (material)
- (6) pump 2 (HP), 50 (yield gpm)
 Electric (type power)
- (7) electric log No (yes or no)
 (organization running log)
- (8) how well bottom plugged PVC Cap

CODED



DEPT. OF NATURAL RESOURCES
 BUREAU OF LAND & WATER RESOURCES


NOV 12 1981

RECEIVED

DRILLERS REMARKS:

If well telescopes please
sketch and show depths.

GROUND LEVEL

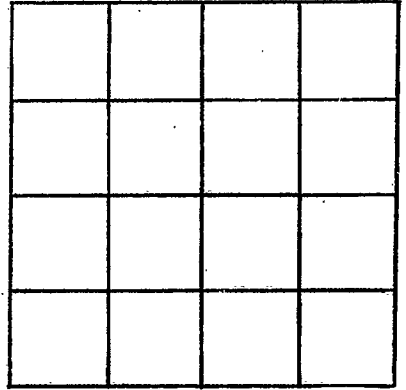

SECTION _____

Please indicate well location X.

ADDITIONAL INFORMATION

If more than one screen,
show locations of each on sketch.