

MISSISSIPPI DEPARTMENT OF NATURAL RESOURCES

Bureau of Land and Water Resources

Southport Mall

P.O. Box 10631

Jackson, Mississippi 39209

WATER WELL DRILLERS LOG

CODED

P14  
SHARKEY CO  
4-6-84

April 6, 1984 date well completed Dyer Well & Irrigation firm name Sharkey county well located

LANDOWNER: <u>Chater Bros.</u>	description of formations encountered	from	to
Rolling Fork, Miss. 39159 (mailing address)	Clay Fine Sand Sand & Gravel	0	45 58 113
WELL LOCATION: <span style="float: right;">CODED</span>			
sec. <u>12</u> T. <u>12</u> (N) S R. <u>6</u> E W <u>1</u> miles <u>East</u> of <u>Rolling Fork</u> (distance) (direction) (nearest town)			
WELL PURPOSE: <u>irrigation</u> (home, irrigation, municipal, industrial)			
WELL COMPLETION DATA:			
(1) diameter (inches) <u>16"</u>			
(2) total depth (feet) <u>113'</u>			
(3) static water level (feet) <u>22'</u> below above top of ground.			
(4) casing <u>Steel</u> , <u>73'</u> (material), (depth) <u>16"</u> If telescope see back. (size)			
(5) screen <u>40'</u> , <u>73'</u> (length), (depth to top)			
(6) pump <u>16"</u> , <u>Steel (Mild)</u> (size), (material)			
(7) pump <u>40</u> , <u>900</u> (HP), (yield gpm)			
<u>Diesel</u> (type power)			
(8) electric log <u>No</u> (yes or no)			
(organization running log)			
(8) how well bottom plugged <u>Plate</u>			


DRILLERS REMARKS:

DEPT. OF NATURAL RESOURCES  
BUREAU OF LAND & WATER RESOURCES

MAY - 4 1984  
RECEIVED

If well telescopes please sketch and show depths.

GROUND LEVEL

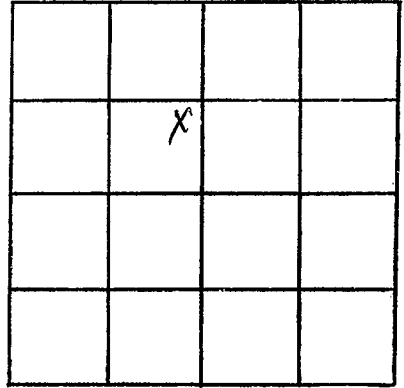

SECTION 12

Please indicate well location X.

ADDITIONAL INFORMATION

If more than one screen,  
show locations of each on sketch.