

MISSISSIPPI DEPARTMENT OF NATURAL RESOURCES

Bureau of Land and Water Resources

Southport Mall

P.O. Box 10631

Jackson, Mississippi 39209

WATER WELL DRILLERS LOG

10

F15
SHARKEY CO.
4-6-84

April 6, 1984 Dyer Well & Irrigation Sharkey  
 date well completed firm name county well located


LANDOWNER:	description of formations encountered	from	to
Chick Bros. Rolling Fork, Miss. 39159 (mailing address)	Clay Sand & Gravel	0	55'
WELL LOCATION: sec. 12 T 12 N S R 6 E W 1 1/4 miles EAST of Rolling Fork (distance) (direction) (nearest town)			
WELL PURPOSE: Irrigation (home, irrigation, municipal, industrial)			
WELL COMPLETION DATA:			
(1) diameter (inches) 16"			
(2) total depth (feet) 108'			
(3) static water level (feet) 22' below top of ground.			
(4) casing Steel, 68' (material) (depth) 16" (size) if telescope see back.			
(5) screen 40' 68' (length) (depth to top) 16" Mild Steel (size) (material)			
(6) pump 40 900 (HP) (yield gpm) Diesel (type power)			
(7) electric log No (yes or no) (organization running log)			
(8) how well bottom plugged Plate			

DEPT. OF NATURAL RESOURCES  
 BUREAU OF LAND & WATER RESOURCES  
 MAY - 4 1984  
 RECEIVED

DRILLERS REMARKS:

If well telescopes please sketch and show depths.

GROUND LEVEL

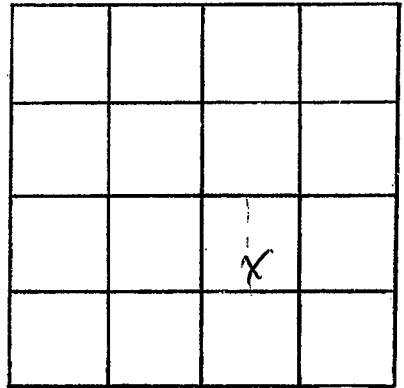

SECTION 12

Please indicate well location X.

ADDITIONAL INFORMATION

If more than one screen, show locations of each on sketch.