

MISSISSIPPI DEPARTMENT OF NATURAL RESOURCES

Bureau of Land and Water Resources

Southport Mall

P.O. Box 10631

Jackson, Mississippi 39209

WATER WELL DRILLERS LOG

JEP
87267-DCP-01
Sharky
P 17

1800
Coted

9-28 1987 Dyer Well Sharky
date well completed firm name county well located

LANDOWNER: Ante Bros
Box 458
Rolling Fork Ms.
(mailing address)

description of formations encountered	from	to
CLAY	0	42
Fine Sand	42	56
M. Sand & Gravel	56	68
Fine Sand	68	75
Sand & Gravel	75	118

WELL LOCATION:
sec 17 12 N R 6 S
W

_____ miles _____ of _____
(distance) (direction) (nearest town)

WELL PURPOSE: Fish Pond
(home, irrigation, municipal, industrial)

WELL COMPLETION DATA:

- (1) diameter (inches) 16"
- (2) total depth (feet) 118'
- (3) static water level (feet) _____ below
top of ground. above
- (4) casing steel _____
(material) (depth)
16"
(size) if telescope see back.
- (5) screen 40' _____
(length) (depth to top)
16"
(size) (material)
- (6) pump 30 _____
(HP) (yield gpm)
Electric
(type power)
- (7) electric log No _____
(yes or no)
None
(organization running log)
- (8) how well bottom plugged Plate

RECEIVED


OCT 30 1987

DRILLERS REMARKS:

Department of Natural Resources
Bureau of Land & Water Resources

If well telescopes please sketch and show depths.

GROUND LEVEL

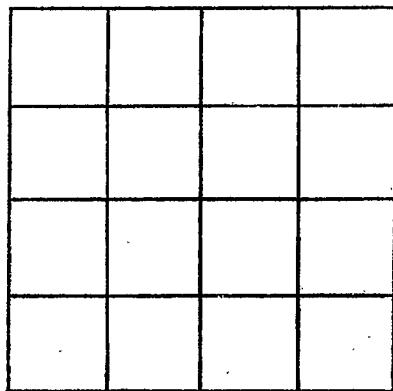

SECTION _____

Please indicate well location X.

ADDITIONAL INFORMATION

If more than one screen,
show locations of each on sketch.