

Sharkey
F 2000
11/8/76

MISSISSIPPI
 BOARD OF WATER COMMISSIONERS
 416 North State Street
 Jackson, Mississippi 39201

WATER WELL DRILLERS LOG

Nov. 8 1976 E.M. "Bud" Cresswell Sharkey
 date well completed firm name county well located

LANDOWNER:
River Run Hunting Club
Greenhead Hunting Club
Holly Bluff, MS.
 (mailing address)

description of formations encountered	from	to
<u>Clay</u>	<u>0</u>	<u>25</u>
<u>panc gravel</u>	<u>25</u>	<u>65</u>

WELL LOCATION:
 sec. 36 T 12 N R 6
3 miles West of Holly Bluff
 (distance) (direction) (nearest town)

WELL PURPOSE: CAMP
 (home, irrigation, municipal, industrial)

- WELL COMPLETION DATA:
- (1) diameter (inches) 2
 - (2) total depth (feet) 65
 - (3) static water level (feet) 18 below top of ground.
 - (4) casing PVC 60
 (material) (depth)
2 if telescope see back.
 (size)
 - (5) screen 5 60
 (length) (depth to top)
2" PVC
 (size) (material)
 - (6) pump 1 10
 (HP) (yield gpm)
0
 (type power)
 - (7) electric log 0
 (yes or no)
0
 (organization running log)
 - (8) how well bottom plugged
Steel plug

RECEIVED


DEC 1 1976

DRILLERS REMARKS:

MISS. BD. OF WATER COMMISSIONERS

If well telescopes please
sketch and show depths.

GROUND LEVEL

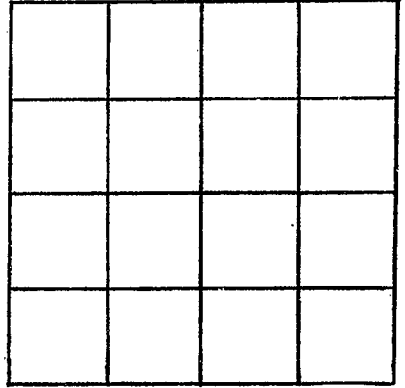

SECTION _____

Please indicate well location X.

ADDITIONAL INFORMATION

If more than one screen,
show locations of each on sketch.