

SHARKEY
F 200
3/6/78

MISSISSIPPI
BOARD OF WATER COMMISSIONERS
416 North State Street
Jackson, Mississippi 39201

WATER WELL DRILLERS LOG

3-6 1978 E.M. "Bud" Cresswell SHARKEY
date well completed firm name county well located

LANDOWNER:
George McClintock
9A200 City, MS.
(mailing address)

description of formations encountered	from	to
Surface deposits	0	25
Sand - gravel	25	90

WELL LOCATION:
sec 12 T 7 N R 6 E
6 12 8
miles EAST of Rolling Fork
(distance) (direction) (nearest town)

WELL PURPOSE: Home
(home, irrigation, municipal, industrial)

- WELL COMPLETION DATA:
- (1) diameter (inches) 2
 - (2) total depth (feet) 90
 - (3) static water level (feet) 16 below top of ground
 - (4) casing PVC 85
(material) (depth)
2 If telescope see back.
(size)
 - (5) screen 5 85
(length) (depth to top)
 - (6) pump 1 10
(HP) (yield gpm)
0
(type power)
 - (7) electric log no
(yes or no)
- (organization running log)

(8) how well bottom plugged
back wash valve

DRILLERS REMARKS:


RECEIVED

MAR 22 1978

MISS. BD. OF WATER COMMISSIONERS

If well telescopes please sketch and show depths.

GROUND LEVEL

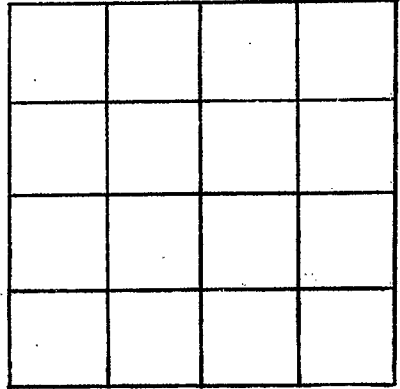

SECTION _____

Please indicate well location X.

ADDITIONAL INFORMATION

If more than one screen, show locations of each on sketch.