

Sharkey
 F 2000
 9-7-79

MISSISSIPPI
 BOARD OF WATER COMMISSIONERS
 416 North State Street
 Jackson, Mississippi 39201

WATER WELL DRILLERS LOG

Sept 7, 1979 Owens Plog. Sharkey
 date well completed firm name county well located

LANDOWNER: Burl y. duerton
Rt 1, Box 417 Rolling Fork, Ms.
 (mailing address)

description of formations encountered	from	to
Top Soil	0	30'
Sand + gravel	30'	140'
Clay	140	180'
Coarse Sand	180	220'
Clay	220	280'
Sand + gravel	280	370'
Sand	370	510'

WELL LOCATION:
 sec. 2 T. 12 N. R. 16 E.
1 miles E of Rolling Fork
 (distance) (direction) (nearest town)

WELL PURPOSE:
 (home, irrigation, municipal, industrial)


- WELL COMPLETION DATA:
- (1) diameter (inches) 2"
 - (2) total depth (feet) 510'
 - (3) static water level (feet) 18' below top of ground.
 - (4) casing PVC 490'
 (material) (depth)
 - (size) if telescope see back.
 - (5) screen 20' 490'
 (length) (depth to top)
 - 2" PVC
 (size) (material)
 - (6) pump 2HP 14
 (HP) (yield gpm)
 - Elec.
 (type power)
 - (7) electric log no
 (yes or no)
 - (organization running log)
 - (8) how well bottom plugged S-B

DRILLERS REMARKS:
Owens

Miss. Board of Water Comm.
 SEP 17 1979
 F-2-11-11

If well telescopes please sketch and show depths.

GROUND LEVEL

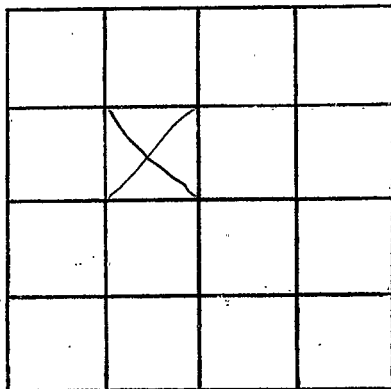

SECTION 2

Please indicate well location X.

ADDITIONAL INFORMATION

If more than one screen, show locations of each on sketch.