

**MISSISSIPPI  
BOARD OF WATER COMMISSIONERS**  
416 North State Street  
Jackson, Mississippi 39201

**WATER WELL DRILLERS LOG**

*Sharkey*  
*F*  
*2003*  
*10-12-79*

*Oct. 12* 19*79* *F.M. "Bud" Cresswell* *Sharkey*  
date well completed firm name county well located

**LANDOWNER:**  
*Bill Moose*  
*Cary, Ms.*  
(mailing address)

| description of formations encountered | from      | to         |
|---------------------------------------|-----------|------------|
| <i>Clay</i>                           | <i>0</i>  | <i>30</i>  |
| <i>Sandst.</i>                        | <i>30</i> | <i>120</i> |

**WELL LOCATION:**  
sec *20* T *12N* R *6E*  
*3* miles *EAST* of *Rolling Fork*  
(distance) (direction) (nearest town)

**WELL PURPOSE:** *farm*  
(home, irrigation, municipal, industrial)

- WELL COMPLETION DATA:**
- (1) diameter (inches) *4*
  - (2) total depth (feet) *120*
  - (3) static water level (feet) *20* below/above top of ground.
  - (4) casing *PVC* *80*  
(material) (depth)  
*4* if telescope see back.  
(size)
  - (5) screen *40* *80*  
(length) (depth to top)  
*4* *PVC*  
(size) (material)
  - (6) pump *2* *50*  
(HP) (yield gpm)  
*0*  
(type power)
  - (7) electric log *0*  
(yes or no)  
*None*  
(organization running log)

(8) how well bottom plugged  
*Ret. plug*

DRILLERS REMARKS:


DEPT. OF NATURAL RESOURCES  
BUREAU OF LAND & WATER RESOURCES

NOV - 6 1979

**RECEIVED**

If well telescopes please sketch and show depths.

GROUND LEVEL

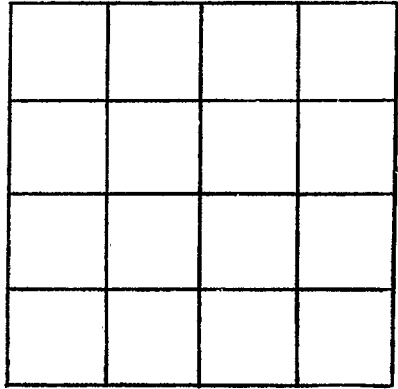

SECTION \_\_\_\_\_

Please indicate well location X:

ADDITIONAL INFORMATION

A series of 20 horizontal lines provided for entering additional information.

If more than one screen, show locations of each on sketch.